

STATE OF KANSAS  
STATE CORPORATION COMMISSION

Give All Information Completely  
Make Required Affidavit  
Mail or Deliver Report to:  
Conservation Division  
State Corporation Commission  
212 North Market, Insurance Bldg.  
Wichita, Kansas

WELL PLUGGING RECORD

15-039-19048-00-00  
DECATUR


County. Sec. <sup>14</sup>/<sub>26</sub>

Twp. 5

Rge. <sup>26</sup>/<sub>11</sub>

(E) (W) X

NORTH

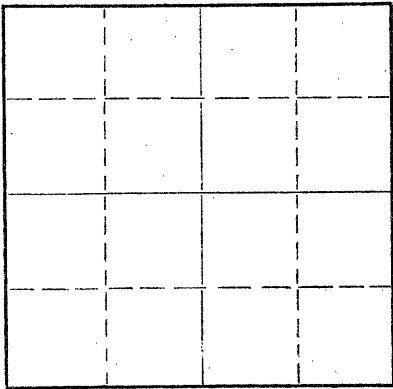

Locate well correctly on above  
Section Plat

Location as "NE/CNW&SW&" or footage from lines C SE SE

Lease Owner IMPERIAL OIL OF KANSAS, INC.

Lease Name HICMERT (CORE HOLE)

Well No. 21

Office Address 780 FOURTH NATIONAL BUILDING

WICHITA 2, KANSAS

Character of Well (completed as Oil, Gas or Dry Hole)

DRY HOLE

Date well completed

OCTOBER 6

19 59

Application for plugging filed

OCTOBER 6

19 59

Application for plugging approved

OCTOBER 6

19 59

Plugging commenced

OCTOBER 6

19 59

Plugging completed

OCTOBER 6

19 59

Reason for abandonment of well or producing formation

CORE HOLE

If a producing well is abandoned, date of last production

19

Was permission obtained from the Conservation Division or its agents before plugging was commenced? YES

Name of Conservation Agent who supervised plugging of this well MR. A.D. FABRICIUS

Producing formation Depth to top Bottom Total Depth of Well 2733 Feet

Show depth and thickness of all water, oil and gas formations.

OIL, GAS OR WATER RECORDS

CASING RECORD

FORMATION	CONTENT	FROM	TO	SIZE	PUT IN	PULLED OUT

RECEIVED  
STATE CORPORATION COMMISSION  
MAR 28 1960  
CONSERVATION DIVISION  
Wichita, Kansas  
3-28-60

Describe in detail the manner in which the well was plugged, indicating where the mud fluid was placed and the method or methods used in introducing it into the hole. If cement or other plugs were used, state the character of same and depth placed, from feet to feet for each plug set.

NO. 1 PLUG SET AT 300' WITH 10 SACKS  
CEMENT; NO. 2 PLUG SET AT 140' WITH  
10 SACKS CEMENT; TOP PLUG SET AT 40'  
WITH 5 SACKS CEMENT.

(If additional description is necessary, use BACK of this sheet)

Name of Plugging Contractor CHEM-TECH

Address BOX 728 HILL CITY, KANSAS

STATE OF KANSAS, COUNTY OF GRAHAM, ss.  
DANIEL F. MCCARTHY (employee of owner) or (owner) or (operator) of the above-described

well, being first duly sworn on oath, says: That I have knowledge of the facts, statements, and matters herein contained and the log of the above-described well as filed and that the same are true and correct. So help me God.

(Signature)

BOX 728 HILL CITY, KANSAS  
(Address)

SUBSCRIBED AND SWORN to before me this 25 day of March, 1960

Donald Law  
Notary Public.

My commission expires

My commission expires May 26, 1960

