

CARD MUST BE TYPED

State of Kansas

CARD MUST BE SIGNED

NOTICE OF INTENTION TO DRILL

(see rules on reverse side)

Expected Spud Date. 1-14-89
month day year

API Number 15— 039-20,841-0000

OPERATOR: License # 3916
Name Felmont Oil Corporation
Address P.O. Box 2266
City/State/Zip Midland, Texas 79702
Contact Person Mr. Tom Cathey
Phone 915-682-5231

SW SW SW Sec. 11 Twp. 5S S, Rg. 26W East
330 West
4950 Ft. from South Line of Section
Ft. from East Line of Section

(Note: Locate well on Section Plat on reverse side)

CONTRACTOR: License # 5302
Name Red Tiger Drilling Company
City/State Wichita, Kansas 67202

Nearest lease or unit boundary line 330 feet
County Decatur
Lease Name Diederich 11 Well # 1

Well Drilled For: Well Class: Type Equipment:
 Oil Storage Infield Mud Rotary
 Gas Inj Pool Ext. Air Rotary
 OWWO Expl Wildcat Cable

Ground surface elevation 2628 feet MSL
Domestic well within 330 feet: yes no
Municipal well within one mile: yes no
Depth to bottom of fresh water 200
Depth to bottom of usable water 1450

If OWWO: old well info as follows:

Surface pipe by Alternate: 1 2
Surface pipe planned to be set 275
Conductor pipe required N/A
Projected Total Depth 4500 feet
Formation ARB

Operator
Well Name
Comp Date Old Total Depth

I certify that well will comply with K.S.A. 55-101, et seq., plus eventually plugging hole to KCC specifications.

Date 12-19-88 Signature of Operator or Agent Ray A. Angle owner

For KCC Use:

BY RED TIGER DRILLING COMPANY

Conductor Pipe Required feet; Minimum Surface Pipe Required 250' feet per Alt. 2

This Authorization Expires 6-20-89 Approved By LKM 12-20-88


EFFECTIVE DATE: 12-25-88

Must be filed with the K.C.C. five (5) days prior to commencing well
This card void if drilling not started within six (6) months of date received by K.C.C.

Important procedures to follow:

1. Notify District office before setting surface casing.
2. Set surface casing by circulating cement to the top.
3. File completion forms ACO-1 with K.C.C. within 120 days of well spud date, following instructions on ACO-1, side 1, and including copies of wireline logs.
4. Notify District office 48 hours prior to old well workover or re-entry.
5. Prior to filing Intent, prepare a proposed plugging plan in case well is D & A, then obtain approval of plan when calling district office prior to setting surface pipe.
6. Submit plugging report (CP-4) to K.C.C. after plugging is completed.
7. Obtain an approved injection docket number before disposing of salt water.
8. Notify K.C.C. within 10 days when injection commences or terminates.
9. If an alternate 2 completion, cement in the production pipe from below any usable water to surface within 120 days of spud date.

**A Regular Section of Land
1 Mile = 5,280 Ft.**

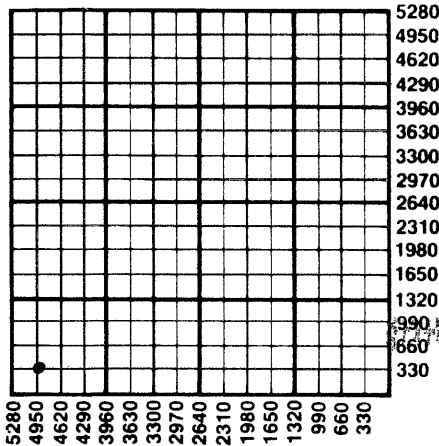

RECEIVED
STATE CORPORATION COMMISSION
WICHITA, KANSAS
DEC 20 1988

12-20-88

State Corporation Commission of Kansas
Conservation Division
200 Colorado Derby Building
Wichita, Kansas 67202-1212
(316) 263-3238