

CARD MUST BE TYPED

State of Kansas

CARD MUST BE SIGNED

NOTICE OF INTENTION TO DRILL

(see rules on reverse side)

Starting Date10-22-86.....
month day year

API Number 15— 039-20,799-00-00
— East

OPERATOR: License #6033.....
Name ...Murfin Drilling Company.....
Address .250.N..Water, Suite.300.....
City/State/ZipWichita, Ks...67202.....
Contact Person.....Todd Aikins.....
Phone.....316-267-3241.....

.NW SW.NE... Sec..8... Twp.5.... S, Rg...26... West
.....3630..... Ft. from South Line of Section
.2310..... Ft. from East Line of Section

(Note: Locate well on Section Plat on reverse side)

CONTRACTOR: License #6033.....
Name ...Murfin Drilling Company.....
City/State.....Wichita, Ks...67202.....

Nearest lease or unit boundary line ...330..... feet
County.....Decatur.....
Lease Name...STRAMEL..... Well #..1-8.....
Ground surface elevation2614..... feet MSL

Well Drilled For: Well Class: Type Equipment:
 Oil SWD Infield Mud Rotary
 Gas Inj Pool Ext. Air Rotary
 OWWO Expl Wildcat Cable

Domestic well within 330 feet: yes no
Municipal well within one mile: yes no
Depth to bottom of fresh water.....200.....
Depth to bottom of usable water1300.....

If OWWO: old well info as follows:

Surface pipe by Alternate: 1 2
Surface pipe planned to be set275.....
Conductor pipe requiredNONE.....
Projected Total Depth ..3820..... feet
Formation.....BKC.....

Operator
Well Name
Comp Date..... Old Total Depth.....

I certify that well will comply with K.S.A. 55-101, et seq., plus eventually plugging hole to KCC specifications.

Date ..10-14-86..... Signature of Operator or Agent

Todd Aikins
Todd Aikins Title...Geologist.....

For KCC Use:

Conductor Pipe Required feet; Minimum Surface Pipe Required250..... feet per Alt. *400*


This Authorization Expires4-14-87..... Approved By10-14-86.....
2/21/86

Must be filed with the K.C.C. five (5) days prior to commencing well
 This card void if drilling not started within six (6) months of date received by K.C.C.

Important procedures to follow:

1. Notify District office before setting surface casing.
2. Set surface casing by circulating cement to the top.
3. File completion forms ACO-1 with K.C.C. within 90 days of well completion, following instructions on ACO-1, side 1, and including copies of wireline logs.
4. Notify District office 48 hours prior to old well workover or re-entry.
5. Prior to filing Intent, prepare a proposed plugging plan in case well is D & A, then obtain approval of plan when calling district office prior to setting surface pipe.
6. Submit plugging report (CP-4) to K. C. C. after plugging is completed.
7. Obtain an approved injection docket number before disposing of salt water.
8. Notify K.C.C. within 10 days when injection commences or terminates.
9. If an alternate 2 completion, cement in the production pipe from below any usable water to surface within 120 days of spud date.

A Regular Section of Land
1 Mile = 5,280 Ft.

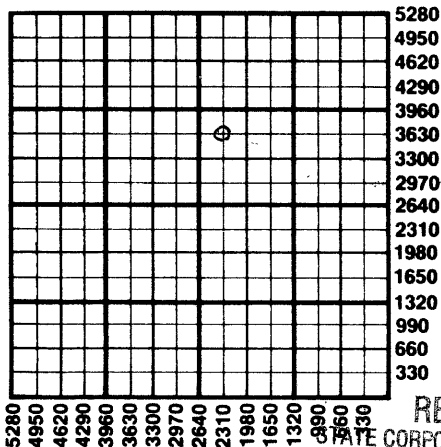

RECEIVED
 CORPORATION COMMISSION

OCT 14 1986
 10-14-86
 CONSERVATION DIVISION
 Wichita, Kansas

State Corporation Commission of Kansas
 Conservation Division
 200 Colorado Derby Building
 Wichita, Kansas 67202
 (316) 263-3238