

CARD MUST BE TYPED

State of Kansas
NOTICE OF INTENTION TO DRILL
(see rules on reverse side)

CARD MUST BE SIGNED

Starting Date: 14 July, 1985
month day year

API Number 15- 039-20,771-00-00

OPERATOR: License # 6467
Name West Kansas Oil -Corp.
Address RR 1 Box 77
City/State/Zip Selden, Kansas 67757
Contact Person Chuck Young
Phone 913-475-2766

NW SW (location) Sec 18 Twp 5 S, Rge 30W
2140 Ft North from Southeast Corner of Section
~~2140~~ 4780 Ft West from Southeast Corner of Section
(Note: Locate well on Section Plat on reverse side)

CONTRACTOR: License # 6033
Name Murfin Drilling company
City/State Wichita, Kansas 67202

Nearest lease or unit boundary line 500 feet.
County Decatur
Lease Name Bastin Well# 1

Well Drilled For: Well Class: Type Equipment:
 Oil Swd Infield Mud Rotary
 Gas Inj Pool Ext. Air Rotary
 OWWO Expl Wildcat Cable

Domestic well within 330 feet: yes no
Municipal well within one mile: yes no

If OWWO: old well info as follows:
Operator
Well Name
Comp Date Old Total Depth
Projected Total Depth 4600 feet
Projected Formation at TD Arbuckle
Expected Producing Formations Lansing-KG

Depth to Bottom of fresh water 200 feet
Lowest usable water formation unconsolidated
Depth to Bottom of usable water 200-250 feet
Surface pipe by Alternate: 1 2
Surface pipe to be set 250 feet
Conductor pipe if any required NA feet
Ground surface elevation feet MSL
This Authorization Expires 1-10-86
Approved By 7-10-85 RCH

I certify that we will comply with K.S.A. 55-101, et seq., plus eventually plugging hole to K.C.C. specifications.

Date 8 July -85 Signature of Operator or Agent


West Kansas Oil Corp by Charles Young pres
RCH for K.O.H.E.

RECEIVED

Must be filed with the K.C.C. five (5) days prior to commencing well
This card void if drilling not started within six (6) months of date received by K.C.C.

07-10-1985
CONSERVATION DIVISION
Wichita, Kansas

A Regular Section of Land
1 Mile = 5,280 Ft.

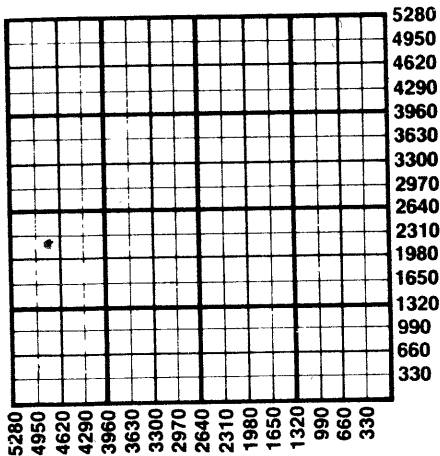

Important procedures to follow :

1. Notify District office before setting surface casing.
2. Set surface casing by circulating cement to the top.
3. File completion forms ACO-1 with K.C.C. within 90 days of well completion, following instructions on ACO-1, side 1, and including copies of wireline logs.
4. Notify District office 48 hours prior to old well workover or re-entry.
5. Prior to plugging, prepare a plugging plan, then obtain agreement from the appropriate district office for an approved plugging plan.
6. Submit plugging report (CP-4) to K.C.C. after plugging is completed.
7. Obtain an approved injection docket number before disposing of salt water.
8. Notify K.C.C. within 10 days when injection commences or terminates.
9. If an alternate 2 completion, cement in the production pipe from below any usable water to surface within 120 days of spud date.

State Corporation Commission of Kansas
Conservation Division
200 Colorado Derby Building
Wichita, Kansas 67202
(316) 263-3238