


STATE OF KANSAS  
STATE CORPORATION COMMISSION

WELL PLUGGING RECORD

Give All Information Completely  
Make Required Affidavit  
Mail or Deliver Report to  
Conservation Division  
State Corporation Comm.  
245 North Water  
Wichita, KS 67202

Rawlins County, Sec. 13 Twp. 5S Rge. 31W E/W  
Location as "NE/CNW 1/4 SW 1/4" or footage from lines  
SE SE NW 330' FEL 330' FSL

Lease Owner Mull Drilling Compa-y  
Lease Name Woerpel Well No. 4  
Office Address P.O. Box 2758, Wichita, KS 67201  
Character of Well (Completed as Oil, Gas or Dry Hole)

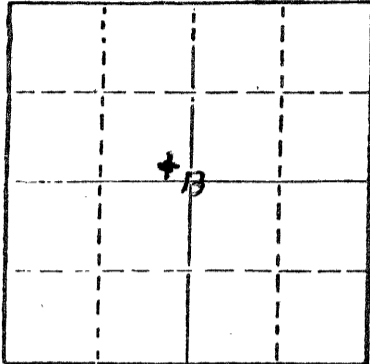

Locate well correctly on above  
Section Plot

Oil - Then well depleted.  
Date Well completed On pump 6/30/80 P&A 7/1/ 19 83  
Application for plugging filed 7/13/83 19 83  
Application for plugging approved 7/1/83 19 83  
Plugging commenced 7/1/83 19 83  
Plugging completed 7/1/83 19 83  
Reason for abandonment of well or producing formation

Well depleted  
If a producing well is abandoned, date of last production 19

Was permission obtained from the Conservation Division or  
its agents before plugging was commenced? Yes

Name of Conservation Agent who supervised plugging of this well Carl Goodrow  
Producing formation Lansing Depth to top 4012 Bottom 4007 Total Depth of Well 4180'  
Show depth and thickness of all water, oil and gas formations.

OIL, GAS OR WATER RECORDS

CASING RECORD

FORMATION	CONTENT	FROM	TO	SIZE	PUT IN	PULLED OUT
				4 1/2"	4205.17'	2436'

Describe in detail the manner in which the well was plugged, indicating where the mud fluid  
was placed and the method or methods used in introducing it into the hold. If cement or other  
plugs were used, state the character of same and depth placed, from \_\_\_\_\_ feet to  
\_\_\_\_\_ feet for each plug set.

Sand to 3950' with 4 sx cement on top

Plugged with 2 sx hulls + 12 sx gel (Halliburton)

100 sx 50-50 poz, 6% gel, 3% cc

28 sx gel - Ran 70 sx 50-50 poz

Released plug 3:15 PM 7/1/83

P&A

State plugger Carl Goodrow

(If additional description is necessary, use BACK of this sheet)

Name of Plugging Contractor Kelso Casing Pulling

P.O. Box 176, Chase, Kansas 67524

STATE OF Kansas COUNTY OF Sedgwick, ss.  
Michael R. Kidwell (employee of owner) or (owner or operator)  
of the above-described well, being first duly sworn on oath, says: That I have knowledge of  
the facts, statements, and matters herein contained and the log of the above-described well  
as filed and that the same are true and correct. So help me God.

(Signature)

*Michael R. Kidwell*  
Michael R. Kidwell  
Mull Drlg Co., P.O. Box 2758, Wichita 67201  
(Address)

SUBSCRIBED AND SWORN TO before me this 14th day of July, 19 83

*Patricia L. Ungleich*  
Patricia L. Ungleich Notary Public.

My commission expires March 27, 1987

RECEIVED  
STATE CORPORATION COMMISSION  
7-20-83  
JUL 20 1983  
CONSERVATION DIVISION  
Wichita, Kansas

PATRICIA L. UNGLEICH  
STATE NOTARY PUBLIC  
Sedgwick County, Kansas  
My Appt. Exp. 3/27/87