


15-153-20033-00-00

STATE OF KANSAS  
STATE CORPORATION COMMISSION

Form CP-4

Give All Information Completely  
Make Required Affidavit  
Mail or Deliver Report to:  
Conservation Division  
State Corporation Commission  
212 No. Market  
Wichita, Kansas

WELL PLUGGING RECORD

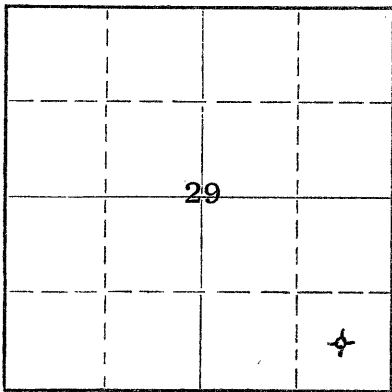

Locate well correctly on above  
Section Plat

Rawlins County, Sec. 29 Twp. 5S Rge. (E) 31 (W)  
Location as "NE/CNW/SW" or footage from lines C SE SE  
Lease Owner Rains & Williamson Oil Co., Inc.  
Lease Name BARNETT Well No. 1  
Office Address 1425 Wichita Plaza-Wichita, Kansas  
Character of Well (completed as Oil, Gas or Dry Hole) Dry Hole  
Date well completed 9-2- 19 68  
Application for plugging filed 9-2 19 68  
Application for plugging approved 9-2 19 68  
Plugging commenced 9-2 19 68  
Plugging completed 7:30 PM 9-2 19 68  
Reason for abandonment of well or producing formation No oil or gas found in commercial quantities.  
If a producing well is abandoned, date of last production -- 19 --  
Was permission obtained from the Conservation Division or its agents before plugging was commenced? Yes

Name of Conservation Agent who supervised plugging of this well Bill Nichols, Moreland, Kansas  
Producing formation \_\_\_\_\_ Depth to top \_\_\_\_\_ Bottom \_\_\_\_\_ Total Depth of Well 4190 Feet  
Show depth and thickness of all water, oil and gas formations.

OIL, GAS OR WATER RECORDS

CASING RECORD

| FORMATION | CONTENT | FROM | TO | SIZE   | PUT IN | PULLED OUT |
|-----------|---------|------|----|--------|--------|------------|
|           |         |      |    | 8-5/8" | 217'   | -0-        |
|           |         |      |    |        |        |            |
|           |         |      |    |        |        |            |
Describe in detail the manner in which the well was plugged, indicating where the mud fluid was placed and the method or methods used in introducing it into the hole. If cement or other plugs were used, state the character of same and depth placed, from \_\_\_\_\_ feet to \_\_\_\_\_ feet for each plug set.

Set first plug at 1756' with 100 sacks 50-50 pozmix, 6% gel.  
Set second plug at 240' with 20 sacks same. Built solid bridge and capped with 10 sacks, 2 sacks in rat hole.

RECEIVED  
STATE CORPORATION COMMISSION  
SEP 6 1968  
CONSERVATION DIVISION  
Wichita, Kansas  
9-6-68

(If additional description is necessary, use BACK of this sheet)  
Name of Plugging Contractor Rains & Williamson Oil Co., Inc.  
Address 1425 Wichita Plaza - Wichita, Kansas 67202

STATE OF KANSAS, COUNTY OF SEDGWICK, ss.  
Wilson Rains (employee of owner) or (owner or operator) of the above-described well, being first duly sworn on oath, says: That I have knowledge of the facts, statements, and matters herein contained and the log of the above-described well as filed and that the same are true and correct. So help me God.

(Signature) Wilson Rains Wilson Rains  
1425 Wichita Plaza - Wichita, Kansas (Address)

SUBSCRIBED AND SWORN to before me this 5th day of September, 19 68

SHERRY GISH  
NOTARY PUBLIC  
My commission expires June 30, 1971

Sherry Gish Notary Public.