

15-153-20030-00-00


STATE OF KANSAS
STATE CORPORATION COMMISSION

Form CP-4

WELL PLUGGING RECORD

Give All Information Completely
Make Required Affidavit
Mail or Deliver Report to:
Conservation Division
State Corporation Commission
212 No. Market
Wichita, Kansas

NORTH

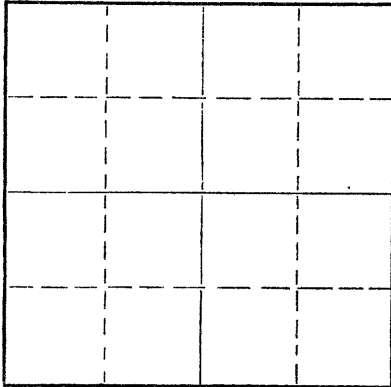

Locate well correctly on above
Section Plat

Rawlins County. Sec. 23 Twp. 5S Rge. 31W (E) (W)
Location as "NE/CNW/SW" or footage from lines C SW NW
Lease Owner Nadel & Gussman
Lease Name Woerpel Well No. 1
Office Address Suite 1714, First Nat'l. Bldg., Tulsa, Oklahoma 74103
Character of Well (completed as Oil, Gas or Dry Hole) D & A
Date well completed 9/6 19 68
Application for plugging filed 9/6 19 68
Application for plugging approved 9/6 19 68
Plugging commenced 9/6 19 68
Plugging completed 9/6 19 68
Reason for abandonment of well or producing formation Dry Hole

If a producing well is abandoned, date of last production 19
Was permission obtained from the Conservation Division or its agents before plugging was commenced yes

Name of Conservation Agent who supervised plugging of this well W. L. NICKLES - Moreland, Kansas
Producing formation _____ Depth to top _____ Bottom _____ Total Depth of Well 4220 Feet
Show depth and thickness of all water, oil and gas formations.

OIL, GAS OR WATER RECORDS

CASING RECORD

FORMATION	CONTENT	FROM	TO	SIZE	PUT IN	PULLED OUT

RECEIVED
STATE CORPORATION COMMISSION
SEP 23 1968
CONSERVATION DIVISION
Wichita, Kansas

9-23-68

Describe in detail the manner in which the well was plugged, indicating where the mud fluid was placed and the method or methods used in introducing it into the hole. If cement or other plugs were used, state the character of same and depth placed, from _____ feet to _____ feet for each plug set.

Bottom plug 1765 w/100 sxs. 50/50 pos. mix 6% gel
2nd plug 340 w/24 sxs.
Top plug 40' w/10 sxs.

(If additional description is necessary, use BACK of this sheet)

Name of Plugging Contractor Murfin Drilling Co.
Address 617 Union Center Bldg., Wichita, Kansas

STATE OF KANSAS, COUNTY OF SEDGWICK, ss.
Jame R. Daniels (employee of owner) or (owner or operator) of the above-described well, being first duly sworn on oath, says: That I have knowledge of the facts, statements, and matters herein contained and the log of the above-described well as filed and that the same are true and correct. So help me God.

(Signature) James R Daniels
(Address) _____

Subscribed and sworn to before me this 20 day of Sept., 1968
Adela Mizener
My Commission expires _____
Adela Mizener, Notary Public
My Commission expires November 5, 1970
Notary Public.



WELL LOG

15-153-20030-00-00

COMPANY Nadel & Gussman

SEC. 23 T. 5S R. 31W
LOC. C SW NW

FARM Woerpel NO. 1

RIG. NO. 3

TOTAL DEPTH 4220'

COMM. 8/26/68


COMP. 9/6/68

SHOT OR TREATED

CONTRACTOR

ISSUED

COUNTRY Rawlins
KANSAS

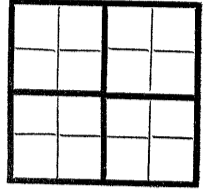

CASING

20	10
15	8 5/8" csg. w/ 250 sxs. HA5
12	6
13	5

ELEVATION

PRODUCTION D & A

FIGURES INDICATE BOTTOM OF FORMATIONS

304	Clay, Sand-Shale
1100	Shale
1765	Shale
2150	Shale
2435	Shale-Lime
2447	Anhydrite
2650	Shale
2755	Shale & lime
2920	Lime & Shale
3140	Lime & Shale
3305	Lime & Shale
3435	Lime & Shale
3512	Lime-Shale
3575	Lime
3735	Lime & Shale
3855	Lime-Shale
3930	Lime & Shale
4008	Lime
4052	Lime
4056	Lime
4109	Lime
4142	Lime
4172	Lime
4220	Lime

State of Kansas
County of Sedgwick } ss:

I, James R. Daniels of the Murfin Drilling Company

upon oath state that the above and foregoing is a true and correct copy of the log of the Woerpel #1 well.

Subscribed and sworn to before me this 20th day of Sept 1968

James R. Daniels

Commission Expires NOVEMBER 5, 1970
ADELA MIZENER, Notary Public

Adela Mizener
NOTARY PUBLIC

