


15-153-00023-00-00

WELL PLUGGING RECORD

Give All Information Completely
Make Required Affidavit
Mail or Deliver Report to:
Conservation Division
State Corporation Commission
800 Bitting Building
Wichita, Kansas

NORTH

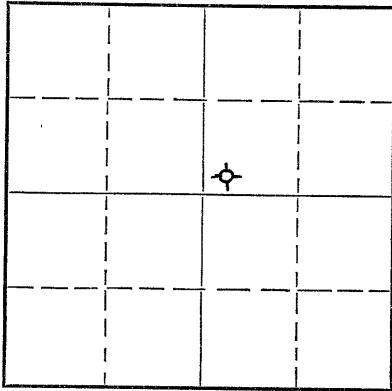

Locate well correctly on above
Section Plat

Rawlins County. Sec. 17 Twp. 5 Rge. 31 (W)
Location as "NE/CNW $\frac{1}{4}$ SW $\frac{1}{4}$ " or footage from lines SW SW NE
Lease Owner B.R.G. Newton, Kansas
Lease Name Hamilton Well No. 1
Office Address 1609 Hillcrest Road, Newton, Kansas
Character of Well (completed as Oil, Gas or Dry Hole) Dry Hole
Date well completed January 23 19 54
Application for plugging filed Verbal January 23 19 54
Application for plugging approved Verbal January 23 19 54
Plugging commenced January 23 19 54
Plugging completed January 23 19 54
Reason for abandonment of well or producing formation Dry Hole

If a producing well is abandoned, date of last production 19
Was permission obtained from the Conservation Division or its agents before plugging was commenced? Yes

Name of Conservation Agent who supervised plugging of this well Eldon Petty
Producing formation Depth to top Bottom Total Depth of Well 4655 Feet
Show depth and thickness of all water, oil and gas formations.

OIL, GAS OR WATER RECORDS

CASING RECORD

| Formation | Content | From | To | Size | Put In | Pulled Out |
|-----------|---------|------|----|------|--------|------------|
| | | | | | | |
| | | | | | | |
Describe in detail the manner in which the well was plugged, indicating where the mud fluid was placed and the method or methods used in introducing it into the hole. If cement or other plugs were used, state the character of same and depth placed, from feet to feet for each plug set.

Plug set at 270 feet. 15 sacks cement 1/2 sack hulls
Mud to 40 feet plug and 10 sacks cement to cellar

2-23-54

(If additional description is necessary, use BACK of this sheet)
Name of Plugging Contractor Bill Hay Drilling Company
Address Hoisington, Kansas

STATE OF KANSAS, COUNTY OF HARVEY, ss.
James G. Gould (employee of owner) or (owner or operator) of the above-described well,

being first duly sworn on oath, says: That I have knowledge of the facts, statements, and matters herein contained and the log of the above-described well as filed and that the same are true and correct. So help me God.

(Signature) James M. Gould
1609 Hillcrest Road, Newton, Kansas
(Address)

SUBSCRIBED AND SWORN to before me this 30th day of January, 19 54

Gladys Carnahan
Notary Public.

My commission expires January 18, 1955

PLUGGING
FILE SEC 12 T 5 R 31W
BOOK PAGE 9 LINE 38