

15-153-30177-00-00

STATE OF KANSAS
STATE CORPORATION COMMISSION

Form CP-4


Give All Information Completely
Make Required Affidavit
Mail or Deliver Report to:
Conservation Division
State Corporation Commission
211 No. Broadway
Wichita, Kansas

WELL PLUGGING RECORD

Rawlins County, Sec. 36 Twp. 5 Rge. 33 (E) (W) x

Location as "NE/CNW/SW" or footage from lines C NW SW
Lease Owner Empire Drilling Company
Lease Name Sacred Heart Church Well No. 1
Office Address 650 Fourth Nat'l. Bank Bldg., Wichita, Kansas 67202
Character of Well (completed as Oil, Gas or Dry Hole) Dry Hole
Date well completed November 13, 1964 19
Application for plugging filed November 13, 1964 19
Application for plugging approved November 13, 1964 19
Plugging commenced November 13, 1964 19
Plugging completed November 13, 1964 19
Reason for abandonment of well or producing formation Dry Hole

NORTH

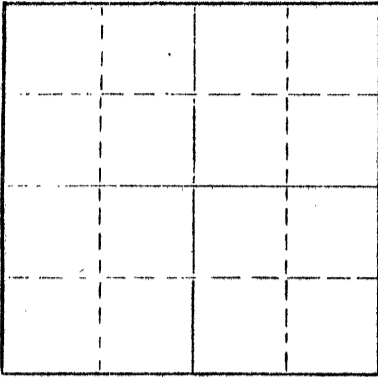

Locate well correctly on above
Section Plat

If a producing well is abandoned, date of last production 19
Was permission obtained from the Conservation Division or its agents before plugging was commenced? yes

Name of Conservation Agent who supervised plugging of this well W. L. Nichols, Morland, Kansas
Producing formation _____ Depth to top _____ Bottom _____ Total Depth of Well 4330 Feet
Show depth and thickness of all water, oil and gas formations.

OIL, GAS OR WATER RECORDS

CASING RECORD

FORMATION	CONTENT	FROM	TO	SIZE	PUT IN	PULLED OUT
Surface &	Sand & Shale	0	278	8 5/8"	275'	-0-

Describe in detail the manner in which the well was plugged, indicating where the mud fluid was placed and the method or methods used in introducing it into the hole. If cement or other plugs were used, state the character of same and depth placed, from _____ feet to _____ feet for each plug set.

Plug set at 600' with 20 sacks cement.
Plug set at 200' with 20 sacks cement.
Plug set at 40' with 10 sacks cement.

RECEIVED
STATE CORPORATION COMMISSION

NOV 23 1964

CONSERVATION DIVISION
Wichita, Kansas

11-23-64

(If additional description is necessary, use BACK of this sheet)

Name of Plugging Contractor Empire Drilling Company
Address 650 Fourth National Bank Building, Wichita, Kansas 67202

STATE OF KANSAS, COUNTY OF SEDGWICK, ss.
Dan J. Kornfeld

(Employee of owner) or (owner or operator) of the above-described well, being first duly sworn on oath, says: That I have knowledge of the facts, statements, and matters herein contained and the log of the above-described well as filed and that the same are true and correct. So help me God.

(Signature) Dan J. Kornfeld
650-4th Nat'l. Bank Bldg., Wichita, Ks. 67202
(Address)

SUBSCRIBED AND SWORN to before me this 20th day of November, 1964

My commission expires October 21, 1966

Lucille H. Harr
Lucille H. Harr Notary Public.

LOG

15-153-30177-00-00

COMPANY: Empire Drilling Company, Wichita, Kansas
 CONTRACTOR: Empire Drilling Company, Wichita, Kansas
 FARM: Sacred Heart Church # 1
 LOCATION: C NW SW Section 36-5S-33W, Rawlins County, Kansas
 COMMENCED: November 3, 1964
 COMPLETED: November 13, 1964
 ELEVATION: 3142 KB
 POTENTIAL: D & A

0	to	70	Surface
70	to	250	Sand
250	to	278	Shale
278	to	770	Shale-Shells
770	to	785	Bentonite
785	to	915	Shale
915	to	1657	Shale-Sand
1657	to	1760	Sand
1760	to	2370	Shale-Shells
2370	to	2468	Shale-Redbed
2468	to	2500	Blaine Gyp
2500	to	2717	Shale-Shells
2717	to	2768	Shale
2768	to	2804	Anhydrite
2804	to	2941	Shale
2941	to	2984	Gyp
2984	to	3435	Shale-Lime
3435	to	3520	Lime
3520	to	3610	Lime-Shale
3610	to	4090	Lime
4090	to	4110	Lime-Chert
4110	to	4330	Lime
4330			Rotary Total Depth

SET: 275' of 8 5/8" with 125 sacks cement.

ELECTRIC LOG TOPS:

Heebner	4003	- 861
Toronto	4035	- 893
Lansing	4052	- 910
Base Kansas City	4294	-1152
Schlumberger Total Depth	4329	

RECEIVED
 STATE CORPORATION COMMISSION
 NOV 23 1964
 11-23-64
 CONSERVATION DIVISION
 Wichita, Kansas

CERTIFICATION

I, Dan J. Kornfeld, do hereby certify that the above and foregoing is a true and correct copy of the log on the Sacred Heart Church # 1, C NW SW Section 36-5S-33W, Rawlins County, Kansas, as reflected by the files of Empire Drilling Company.

Dan J. Kornfeld
 DAN J. KORNFELD

Subscribed and sworn to before me, a Notary Public, within and for Sedgwick County, Kansas, this 20th day of November, 1964.

Lucille H. Harr
 LUCILLE H. HARR, Notary Public

My commission expires October 21, 1966