


STATE OF KANSAS
STATE CORPORATION COMMISSION

WELL PLUGGING RECORD

Give All Information Completely
Make Required Affidavit
Mail or Deliver Report to
Conservation Division
State Corporation Comm.
245 North Water
Wichita, KS 67202

Rawlins County, Sec. 10 Twp. 5S Rge. 33 ~~2S~~W
Location as "NE/CNW $\frac{1}{4}$ SW $\frac{1}{4}$ " or footage from lines
660' FEL & FSLNW/4

Lease Owner Nielson Enterprises, Inc.
Lease Name Curtin Well No. #1
Office Address First of Denver Plaza - Suite 1380, Denver,
Character of Well (Completed as Oil, Gas or Dry Hole)

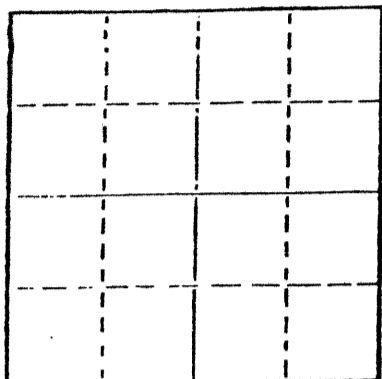

Locate well correctly on above
Section Plot

Dry Hole
Date Well completed 6-13-78 19
Application for plugging filed 6-13-78 19
Application for plugging approved 6-13-78 19
Plugging commenced 6-13-78 19
Plugging completed 6-13-78 19

Reason for abandonment of well or producing formation
Commercial quantities of oil not found
If a producing well is abandoned, date of last production 19

Was permission obtained from the Conservation Division or
its agents before plugging was commenced? Yes

Name of Conservation Agent who supervised plugging of this well Gilbert Balthazor, Palco, Ks.
Producing formation _____ Depth to top _____ Bottom _____ Total Depth of Well 4632'
Show depth and thickness of all water, oil and gas formations.

OIL, GAS OR WATER RECORDS

CASING RECORD

FORMATION	CONTENT	FROM	TO	SIZE	PUT IN	PULLED OUT
				8 5/8"	287'	None

Describe in detail the manner in which the well was plugged, indicating where the mud fluid was placed and the method or methods used in introducing it into the hold. If cement or other plugs were used, state the character of same and depth placed, from _____ feet to _____ feet for each plug set.

Plug @ 1750' w/70 sx.
Plug @ 270' w/20 sx.
Plug @ 40' w/10 sx.
Rat Hole 2 sx.

RECEIVED
STATE CORPORATION COMMISSION

SEP 25 1978

CONSERVATION DIVISION
Wichita, Kansas

9-25-78

(If additional description is necessary, use BACK of this sheet)

Name of Plugging Contractor Rains & Williamson Oil Co., Inc.

STATE OF Kansas COUNTY OF Sedgwick, ss.

Wilson Rains, President of Rains & Williamson Oil Co., Inc. (employee of owner) or (owner or operator) of the above-described well, being first duly sworn on oath, says: That I have knowledge of the facts, statements, and matters herein contained and the log of the above-described well as filed and that the same are true and correct. So help me God.

(Signature)

Wilson Rains

435 Page Court, 220 W. Douglas, Wichita, Ks. 67202
(Address)

15 day of June, 1978

Sherry Herrell
Sherry Herrell Notary Public.



Subscribed AND SWORN TO before me this

1-5-82

DRILLER'S LOG

COMPANY: Nielson Enterprises, Inc.

SEC. 10 T. 5S R. 33W

WELL NAME: Curtin #1

LOC. NW/4 (660' FEL &
COUNTY: 660' FSL of NW/4
Rawlins

RIG NO. #1

TOTAL DEPTH 4632'

ELEVATION

COMMENCED: 5-30-78

COMPLETED: 6-13-78

CONTRACTOR: Rains & Williamson Oil Co., Inc.

CASING RECORD:

SURFACE: 8 5/8" @ 287' w/225 sx. 40/60 poz., 2% gel, 3%cc.

PRODUCTION: D&A

LOG

(Figures Indicate Bottom of Formations)

Sand & Shale	288
Shale	579
Sand & Shale	2172
Shale & Sand	2504
Shale	3550
Shale & Lime	3702
Shale	4014
Lime	4020
Lime & Shale	4146
Lime	4191
Lime & Shale	4214
Lime	4396
Lime & Shale	4412
Lime	4464
Lime & Shale	4632
<u>ROTARY TOTAL DEPTH</u>	<u>4632</u>

RECEIVED
STATE CORPORATION COMMISSION

SEP 25 1978
9-25-78
CONSERVATION DIVISION
Wichita, Kansas

STATE OF Kansas)
COUNTY OF Sedgwick) SS:

I, Wilson Rains, President of Rains & Williamson Oil Co., Inc.
upon oath state that the above and foregoing is a true and correct copy of the log of the
Curtin #1 well.

Wilson Rains
Wilson Rains

Subscribed and sworn to before me this 15 day of June, 1978.

My Appointment Expires:
1-5-82

Sherry Herrell
Sherry Herrell

