


15-153-20283-00-00

STATE OF KANSAS
STATE CORPORATION COMMISSION

WELL PLUGGING RECORD

Give All Information Completely
Make Required Affidavit
Mail or Deliver Report to
Conservation Division
State Corporation Comm.
245 North Water
Wichita, KS 67202

RAWLINS County. Sec. 31 Twp. 5S Rge. 32 8/W
Location as "NE/CNW 1/4 SW 1/4" or footage from lines C-SE-SE
660' FSL + 660' FEL OF SECTION.
Lease Owner BASS ENTERPRISES PRODUCTION Co.
Lease Name HENNINGSEN Well No. 1
Office Address Box 2760, MIDLAND, TX 79702
Character of Well (Completed as Oil, Gas or Dry Hole) _____

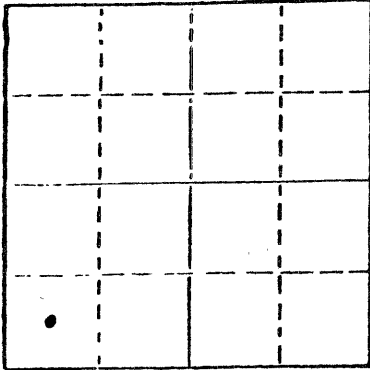

Locate well correctly on above
Section Plat

Date Well completed MAY 13, 1977
Application for plugging filed MAY 13, 1977
Application for plugging approved MAY 13, 1977
Plugging commenced MAY 13, 1977
Plugging completed MAY 13, 1977
Reason for abandonment of well or producing formation DRY HOLE

If a producing well is abandoned, date of last production _____ 19__

Was permission obtained from the Conservation Division or its agents before plugging was commenced? YES

Name of Conservation Agent who supervised plugging of this well GILBERT BALTHAZOR, PALCO, KS
Producing formation _____ Depth to top _____ Bottom _____ Total Depth of Well 450'
Show depth and thickness of all water, oil and gas formations.

OIL, GAS OR WATER RECORDS

CASING RECORD

FORMATION	CONTENT	FROM	TO	SIZE	PUT IN	PULLED OUT
<u>No oil or gas formations encountered</u>				<u>8 5/8"</u>	<u>327'</u>	<u>NONE</u>

Describe in detail the manner in which the well was plugged, indicating where the mud fluid was placed and the method or methods used in introducing it into the hold. If cement or other plugs were used, state the character of same and depth placed, from _____ feet to _____ feet for each plug set.

70 SKS 50-50 POZ MIX w/6% GEL FROM 1650' TO 1334'
20 SKS 50-50 POZ MIX w/6% GEL FROM 300' TO 212'
DROVE RUBBER PLUG TO 38' - CAPPED w/8 SKS 50-50 POZ MIX
w/6% GEL.
INTERVALS BETWEEN PLUGS FILLED WITH 10.3# MUD.

RECEIVED
STATE CORPORATION COMMISSION
MAY 27 1977
5-27-77

(If additional description is necessary, use BACK of this sheet)

Name of Plugging Contractor RAINS & WILLIAMSON DRILLING Co., INC.

STATE OF TEXAS COUNTY OF MIDLAND, ss.
J. H. F. WURTZ, JR. (employee of owner) or (owner or operator)
of the above-described well, being first duly sworn on oath, says: That I have knowledge of the facts, statements, and matters herein contained and the log of the above-described well as filed and that the same are true and correct. So help me God.

(Signature) J. H. F. Wurtz, Jr.
SR. PROD. CHIEF
(Address)

SUBSCRIBED AND SWORN TO before me this 24TH day of MAY, 1977

My commission expires JUNE 1-1977
B. R. Adams
MIDLAND COUNTY, TEXAS Notary Public.

DRILLER'S LOG

15-153-20283-00-00

COMPANY: Bass Enterprises Production Co.

SEC. 31 T. 5S R. 32W

WELL NAME: Henningsen #1

LOC. C SE SE

COUNTY: Rawlins

RIG NO. #1

TOTAL DEPTH 4150'

ELEVATION

COMMENCED: 5-5-77

COMPLETED: 5-13-77

CONTRACTOR: Rains & Williamson Oil Co., Inc.

CASING RECORD:

SURFACE: 8 5/8" @ 327' w/230 sx. 50/50 poz., 3% cc., 2% gel.

PRODUCTION: D&A

LOG

(Figures Indicate Bottom of Formations)

Sand & Clay	160
Sand, Clay & Shale	327
Shale	534
Shale & Sand	1600
Sand & Shale	2030
Shale & Sand	2754
Shale, Sand & Lime	3010
Shale & Lime	3240
Shale, Sand & Lime	3418
Shale & Lime	3575
Lime & Shale	3805
Lime	3920
Lime & Shale	4007
Shale & Lime	4150
<u>ROTARY TOTAL DEPTH</u>	<u>4150</u>

RECEIVED
 STATE CORPORATION COMMISSION
 5-27-77
 MAY 27 1977
 CONSERVATION DIVISION
 Wichita, Kansas

STATE OF Kansas)
 COUNTY OF Sedgwick) SS:

I, Wilson Rains, President of Rains & Williamson Oil Co., Inc.
 upon oath state that the above and foregoing is a true and correct copy of the log of the
Henningsen #1 well.

Wilson Rains
 Wilson Rains

Subscribed and sworn to before me this 16 day of May, 1977.

My Appointment Expires:
10-4-79

Juanita M. Green
 Juanita M. Green

