

CARD MUST BE TYPED

State of Kansas
NOTICE OF INTENTION TO DRILL
(see rules on reverse side)

CARD MUST BE SIGNED

Starting Date: 12 31 84
month day year

API Number 15- 153-20,588-00-00

OPERATOR: License # 6467
Name West Kansas Crude, Inc.
Address R. R. #1
City/State/Zip Selden, KS 67757
Contact Person Chuck Young
Phone 913-475-2766

C... NE... SE... Sec 13... Twp 5... S, Rge 31...
(location) East West

1980 Ft North from Southeast Corner of Section
660 Ft West from Southeast Corner of Section
(Note: Locate well on Section Plat on reverse side)

CONTRACTOR: License # 6033
Name Murfin Drilling Company
City/State Wichita, KS 67202

Nearest lease or unit boundary line ... 660 feet.
County Rawlins
Lease Name Springer "B" Well# 5

Domestic well within 330 feet: yes no
Municipal well within one mile: yes no

Well Drilled For: Well Class: Type Equipment:
 Oil Swd Infield Mud Rotary
 Gas Inj Pool Ext. Air Rotary
 OWWO Expl Wildcat Cable

Depth to Bottom of fresh water ... 200 feet
Lowest usable water formation ... Unconsolidated
Depth to Bottom of usable water ... 1750 200 feet

If OWWO: old well info as follows:

Operator
Well Name
Comp Date Old Total Depth
Projected Total Depth 4800 feet
Projected Formation at TD Grn. Wash
Expected Producing Formations LKC

Surface pipe by Alternate: 1 2
Surface pipe to be set 250 feet
Conductor pipe if any required ... N/A feet
Ground surface elevation feet MSL
This Authorization Expires 6-27-85
Approved By RCH/KCC 12-27-84

I certify that we will comply with K.S.A. 55-101, et seq., plus eventually plugging hole to K.C.C. specifications.

Date 12-27-84 Signature of Operator or Agent

Jack E. Goss
Jack E. Goss, Agent for Operator Title Ass't. Drilling Manager
MHC/KOHE 12/27/84 Form C-1 4/84


RECEIVED
STATE CORPORATION COMMISSION

DEC 27 1984
CONSERVATION DIVISION
Wichita, Kansas

Must be filed with the K.C.C. five (5) days prior to commencing well
This card void if drilling not started within six (6) months of date received by K.C.C.

12-27-84
Rec'd

Acquisition Section of Land
1 Mile = 5,280 Ft.

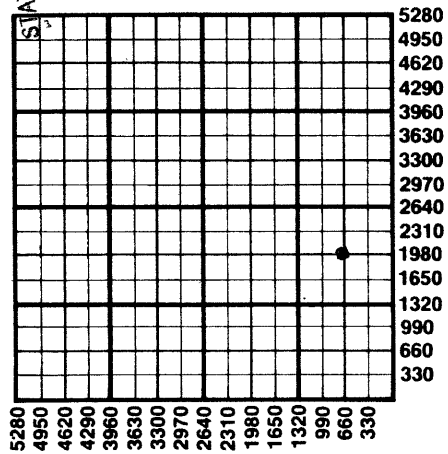

R

Important procedures to follow :

1. Notify District office before setting surface casing.
2. Set surface casing by circulating cement to the top.
3. File completion forms ACO-1 with K.C.C. within 90 days of well completion, following instructions on ACO-1, side 1, and including copies of wireline logs.
4. Notify District office 48 hours prior to old well workover or re-entry.
5. Prior to plugging, prepare a plugging plan, then obtain agreement from the appropriate district office for an approved plugging plan.
6. Submit plugging report (CP-4) to K.C.C. after plugging is completed.
7. Obtain an approved injection docket number before disposing of salt water.
8. Notify K.C.C. within 10 days when injection commences or terminates.
9. If an alternate 2 completion, cement in the production pipe from below any usable water to surface within 120 days of spud date.

State Corporation Commission of Kansas
Conservation Division
200 Colorado Derby Building
Wichita, Kansas 67202
(316) 263-3238