


15-023-20177-00-00

STATE OF KANSAS
STATE CORPORATION COMMISSION

WELL PLUGGING RECORD

Give All Information Completely
Make Required Affidavit
Mail or Deliver Report to
Conservation Division
State Corporation Comm.
245 North Water
Wichita, KS 67202

Cheyenne County. Sec. 4 Twp. 5S Rge. 37 E/W
Location as "NE/CNW $\frac{1}{2}$ SW $\frac{1}{2}$ " or footage from lines
1980' FWL & 660' FNL
Lease Owner Nielson Enterprises, Inc.
Lease Name Briney Well No. #1
Office Address 1675 Broadway - Suite 2770, Denver, Colo.
Character of Well (Completed as Oil, Gas or Dry Hole) Dry Hole

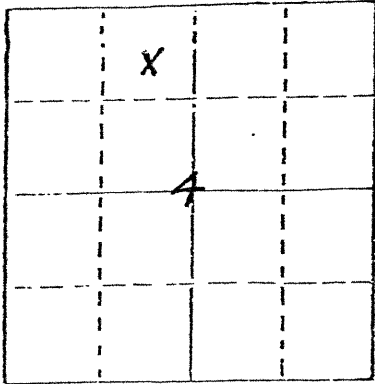

Locate well correctly on above Section Plat

Date Well completed 6-29-81 19
Application for plugging filed 6-29-81 19
Application for plugging approved 6-29-81 19
Plugging commenced 6-29-81 19
Plugging completed 6-29-81 19
Reason for abandonment of well or producing formation Commercial quantities of oil not found

If a producing well is abandoned, date of last production 19

Was permission obtained from the Conservation Division or its agents before plugging was commenced? Yes

Name of Conservation Agent who supervised plugging of this well Marion Schmidt
Producing formation _____ Depth to top _____ Bottom _____ Total Depth of Well 4970
Show depth and thickness of all water, oil and gas formations.

OIL, GAS OR WATER RECORDS

CASING RECORD

FORMATION	CONTENT	FROM	TO	SIZE	PUT IN	PULLED OUT
				8 5/8"	363'	None

Describe in detail the manner in which the well was plugged, indicating where the mud fluid was placed and the method or methods used in introducing it into the hold. If cement or other plugs were used, state the character of same and depth placed, from _____ feet to _____ feet for each plug set.

- Plug @ 1980' w/60 sx.
- Plug @ 390' w/30 sx.
- Plug @ 40' w/10 sx.
- Rat Hole 5 sx.

RECEIVED
STATE CORPORATION COMMISSION

1111 271981

(If additional description is necessary, use BACK of this sheet)
Name of Plugging Contractor Rains & Williamson Oil Co., Inc. 9-27-81
Conservation Division
Wichita, Kansas

STATE OF Kansas COUNTY OF Sedgwick, ss.
I, Wilson Rains, President of Rains & Williamson Oil Co. (employee of owner) or (owner or operator of the above-described well, being first duly sworn on oath, says: That I have knowledge of the facts, statements, and matters herein contained and the log of the above-described well as filed and that the same are true and correct. So help me God.

(Signature) Wilson Rains
435 Page Court, 220 W. Douglas, Wichita, Ks. 67202
(Address)

SUBSCRIBED AND SWORN TO before me this 1 day of July, 19 81

My commission expires 10-4-83

Juanita M. Green
Juanita M. Green Notary Public.

18-023-20177-00-00

Wichita
file

DRILLER'S LOG

COMPANY: Nielson Enterprises, Inc.

SEC. 4 T. 5S R. 37W

WELL NAME: Briney #1

LOC. 1980' FWL & 660' FNL

COUNTY: Cheyenne

RIG NO. #1

TOTAL DEPTH 4970'

ELEVATION

COMMENCED: 6-15-81

COMPLETED: 6-29-81

CONTRACTOR: Rains & Williamson Oil Co., Inc.

CASING RECORD:

SURFACE: 8 5/8" @ 363' w/250 sx. 60/40 poz., 2% gel, 3% cc.

PRODUCTION: D&A

LOG

(Figures Indicate Bottom of Formations)

Sand & Clay	291
Shale	2113
Shale & Sand	2610
Shale	2933
Shale & Sand	3099
Shale	3425
Shale & Lime	3477
Shale	3663
Shale & Lime	3800
Shale	4000
Shale & Lime	4110
Shale	4334
Shale & Lime	4420
Lime	4495
Shale & Lime	4588
Shale	4970
<u>ROTARY TOTAL DEPTH</u>	<u>4970</u>


RECEIVED
STATE CORPORATION COMMISSION

271981
7-27-81
CONSERVATION DIVISION
Wichita, Kansas

STATE OF Kansas)
COUNTY OF Sedgwick) SS:

I, Wilson Rains, President of Rains & Williamson Oil Co., Inc.
upon oath state that the above and foregoing is a true and correct copy of the log of the
Briney #1 well.

Wilson Rains
Wilson Rains

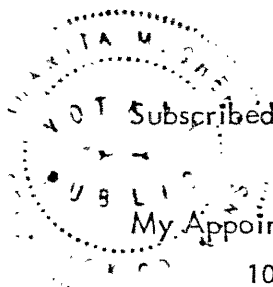

Subscribed and sworn to before me this 1 day of July, 1981.

My Appointment Expires:
10-4-83

Juanita M. Green
Juanita M. Green