


WELL PLUGGING RECORD

Give All Information Completely  
Make Required Affidavit  
Mail or Deliver Report to:  
Conservation Division  
State Corporation Commission  
800 Bitting Building  
Wichita, Kansas

NORTH

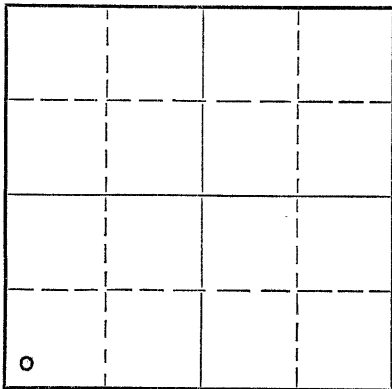

Locate well correctly on above  
Section Plat

Decatur County. Sec. 25 Twp. 5 S Rge. 27 (E) W (W)  
Location as "NE/CNW $\frac{1}{4}$ SW $\frac{1}{4}$ " or footage from lines SW $\frac{1}{4}$  SW $\frac{1}{4}$  SW $\frac{1}{4}$  SW $\frac{1}{4}$   
Lease Owner Barnett Drilling, Inc., et al  
Lease Name Noone Well No. 1  
Office Address 623 First National Bank Bldg., Wichita 2, Kansas  
Character of Well (completed as Oil, Gas or Dry Hole) Dry Hole  
Date well completed May 15 19 52  
Application for plugging filed May 15 19 52  
Application for plugging approved May 15 19 52  
Plugging commenced May 15 19 52  
Plugging completed May 15 19 52  
Reason for abandonment of well or producing formation

If a producing well is abandoned, date of last production 19  
Was permission obtained from the Conservation Division or its agents before plugging was commenced? Yes

Name of Conservation Agent who supervised plugging of this well Eldon Petty  
Producing formation Depth to top Bottom Total Depth of Well 1225 Feet  
Show depth and thickness of all water, oil and gas formations.

OIL, GAS OR WATER RECORDS

CASING RECORD

Formation	Content	From	To	Size	Put In	Pulled Out
		0	267	8 5/8"	267	0

Describe in detail the manner in which the well was plugged, indicating where the mud fluid was placed and the method or methods used in introducing it into the hole. If cement or other plugs were used, state the character of same and depth placed, from feet to feet for each plug set.

Filled hole with heavy mud from 1225 feet to 265 feet. Set wooden plug at 265 feet. Filled with one-half sack of hulls and 15 sacks of cement to 215 feet. Filled with heavy mud to 140 feet. Set top wooden plug at 140 feet. Dumped one-half sack of hulls on plug and filled to bottom of cellar with 10 sacks of cement.

Conservation Division  
Wichita, Kansas  
5-20-52

(If additional description is necessary, use BACK of this sheet)  
Name of Plugging Contractor Barnett Drilling, Inc.  
Address 623 First National Bank Building  
Wichita, 2, Kansas

STATE OF Kansas, COUNTY OF Sedgwick, ss.  
F. R. Stubblefield (employee of owner) or (owner or operator) of the above-described well,  
being first duly sworn on oath, says: That I have knowledge of the facts, statements, and matters herein contained and the log of the above-described well as filed and that the same are true and correct. So help me God.

(Signature) F. R. Stubblefield  
623 First National Bank Building, Wichita, Ks.  
(Address)

SUBSCRIBED AND SWORN to before me this 19th day of May, 1952.  
Mildred F. Willis  
Notary Public.

My commission expires February 27, 1956  
23-8390-s 6-51-20M

PLUGGING  
FILE REC 25 T 5 R 27 W  
BOOK PAGE 16 LINE 44