15-039-00056-00-00

STATE OF KANSAS
STATE CORPORATION COMMISSION

Give All Information Completely
Make Required Affidavit
Mail or Deliver Report to:
Conservation Division
State Corporation Commission
800 Bitting Building
Wichita, Kansas

WELL PLUGGING RECORD

NORTH

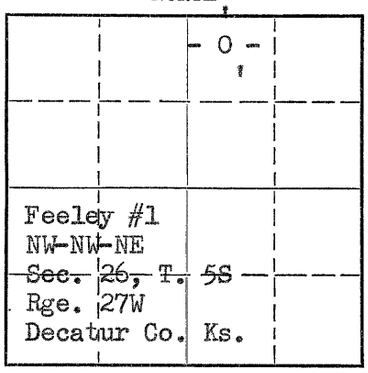

Locate well correctly on above Section Plat

Decatur County. Sec. 26 Twp. 5S Rge. 27 (E) W (W)
Location as "NE/CNW¼SW¼" or footage from lines NW-NW-NE
Lease Owner Harry Gore
Lease Name Feeley Well No. #1
Office Address 400 Brown Bldg.
Character of Well (completed as Oil, Gas or Dry Hole) Dry Hole
Date well completed 3-3 1952
Application for plugging filed 3-3 1952
Application for plugging approved 3-3 1952
Plugging commenced 3-3 12:00 A. M. 1952
Plugging completed 3-3 4:00 P. M. 1952
Reason for abandonment of well or producing formation Dry Hole

If a producing well is abandoned, date of last production 19..
Was permission obtained from the Conservation Division or its agents before plugging was commenced? Yes - Venbal
Name of Conservation Agent who supervised plugging of this well Eldon Petty
Producing formation ..... Depth to top ..... Bottom ..... Total Depth of Well 4210 Feet
Show depth and thickness of all water, oil and gas formations.

OIL, GAS OR WATER RECORDS — CASING RECORD

Formation	Content	From	To	Size	Put In	Pulled Out
Shale & Soil		0	262'	8 5/8	262'	None
Lansing (K. C.)		3701'	4128'		Dry	Dry
Conglamerate		4128'	4177'		Dry	Dry
Arbuckle		4177'	4210'		Dry	Dry

Describe in detail the manner in which the well was plugged, indicating where the mud fluid was placed and the method or methods used in introducing it into the hole. If cement or other plugs were used, state the character of same and depth placed, from ..... feet to ..... feet for each plug set.

Stirred pits well. Filled hole with heavy mud to 250' Set bottom wood plug at 250'. Ran ½ sack Hulls and 15 sacks cement. Filled hole with heavy mud to 40' Set wood plug at 40'. Ran ½ sack hulls and 10 sacks cement, filling to bottom of Cellar

(If additional description is necessary, use BACK of this sheet)

Name of Plugging Contractor Strain Drilling Company
Address 117½ East 8th Box 188
Hays, Kansas

STATE OF Kansas, COUNTY OF Ellis, ss.
T. C. Strain (employee of owner) or (owner or operator) of the above-described well, being first duly sworn on oath, says: That I have knowledge of the facts, statements, and matters herein contained and the log of the above-described well as filed and that the same are true and correct. So help me God.

(Signature) T. C. Strain
Box 188 Hays, Kansas
(Address)

SUBSCRIBED AND SWORN TO before me this 6th day of March 19 52

Zita Paden
Notary Public.

My commission expires Dec 31-1954

23-8390-s 6-51—20M

PLUGGING
FILE SEC 26 T 5 R 27W
FAGE 148 LINE 41

3-8-52