


15-039-00137-00-00

STATE OF KANSAS  
STATE CORPORATION COMMISSION

Give All Information Completely  
Make Required Affidavit  
Mail or Deliver Report to:  
Conservation Division  
State Corporation Commission  
211 No. Broadway  
Wichita, Kansas

WELL PLUGGING RECORD

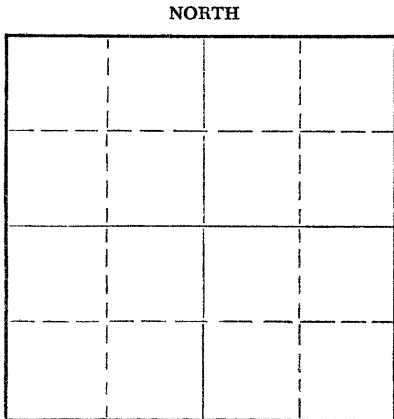

Locate well correctly on above  
Section Plat

Decatur County, Sec 25 Twp 5S Rge 27W (E) (W)  
Location as "NE/CNW/SW" or footage from lines SW SW SE  
Lease Owner Burch Drilling Co., Inc.  
Lease Name Gritz Well No. 1  
Office Address 1011 Union Center, Wichita, Kansas  
Character of Well (completed as Oil, Gas or Dry Hole) Dry Hole  
Date well completed 12-18-59 19  
Application for plugging filed 12-18-59 19  
Application for plugging approved 12-18-59 19  
Plugging commenced 12-18-59 19  
Plugging completed 12-18-59 19  
Reason for abandonment of well or producing formation Dry Hole

If a producing well is abandoned, date of last production \_\_\_\_\_ 19  
Was permission obtained from the Conservation Division or its agents before plugging was commenced? yes

Name of Conservation Agent who supervised plugging of this well A. L. Fabricus  
Producing formation \_\_\_\_\_ Depth to top \_\_\_\_\_ Bottom \_\_\_\_\_ Total Depth of Well 3910' Feet  
Show depth and thickness of all water, oil and gas formations.

OIL, GAS OR WATER RECORDS

CASING RECORD

FORMATION	CONTENT	FROM	TO	SIZE	PUT IN	PULLED OUT

Describe in detail the manner in which the well was plugged, indicating where the mud fluid was placed and the method or methods used in introducing it into the hole. If cement or other plugs were used, state the character of same and depth placed, from \_\_\_\_\_ feet to \_\_\_\_\_ feet for each plug set.

1st plug set at 500' with 20 sacks cement.  
2nd plug set at 210' with 20 sacks cement.  
3rd plug set at 40' with 10 sacks cement.

RECEIVED  
STATE CORPORATION COMMISSION  
DEC 24 1959  
CONSERVATION DIVISION  
Wichita, Kansas

12-24-59

(If additional description is necessary, use BACK of this sheet)

Name of Plugging Contractor Burch Drilling Co., Inc.  
Address 1011 Union Center, Wichita, Kansas

STATE OF KANSAS, COUNTY OF SEDGWICK, ss.  
Earl M. Burch, President (employee of owner) or (owner or operator) of the above-described well, being first duly sworn on oath, says: That I have knowledge of the facts, statements, and matters herein contained and the log of the above-described well as filed and that the same are true and correct. So help me God.

(Signature) Earl M. Burch  
Earl M. Burch  
1011 Union Center  
Wichita, Kansas

SUBSCRIBED AND SWORN TO before me this 23rd day of December, 19 59.

My commission expires March 12, 1963.  
Shirley Ann Arnn  
Shirley Ann Arnn Notary Public.

