


15-039-20433-00-00

STATE OF KANSAS
STATE CORPORATION COMMISSION.

WELL PLUGGING RECORD

Give All Information Completely
Make Required Affidavit
Mail or Deliver Report to
Conservation Division
State Corporation Comm.
245 North Water
Wichita, KS 67202

Decator County. Sec. 29 Twp. 5 Rge. 29 E/W
Location as "NE/CNW 1/4 SW 1/4" or footage from lines
NE SW NE
Lease Owner Nelson Petroleum Co.
Lease Name Everett Shuler #1 Well No.
Office Address Tulsa, Oklahoma 74119
Character of Well (Completed as Oil, Gas or Dry Hole)

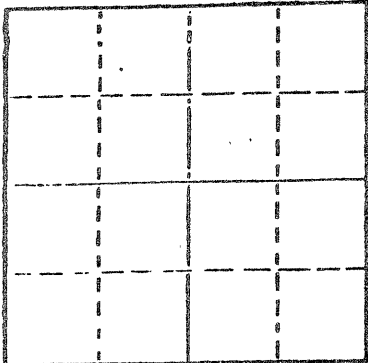

Locate well correctly on above
Section Plat

Date Well completed 19
Application for plugging filed 19
Application for plugging approved 19
Plugging commenced 5/25/79 19
Plugging completed 5/31/79 19
Reason for abandonment of well or producing formation depleted.

If a producing well is abandoned, date of last production 19

Was permission obtained from the Conservation Division or its agents before plugging was commenced? yes

Name of Conservation Agent who supervised plugging of this well Balthazor
Producing formation Depth to top Bottom Total Depth of Well 4450
Show depth and thickness of all water, oil and gas formations.

OIL, GAS OR WATER RECORDS

CASING RECORD

FORMATION	CONTENT	FROM	TO	SIZE	PUT IN	PULLED OUT
				8-5/8	307	none
				4 1/2"	4155	1796'

Describe in detail the manner in which the well was plugged, indicating where the mud fluid was placed and the method or methods used in introducing it into the hold. If cement or other plugs were used, state the character of same and depth placed, from feet to feet for each plug set.

Pushed wood plug to 4100' and sanded to 4075', ran 4 sacks cement. Loaded hole with salt water, shot pipe at 2324', 2003', 1905', 1802', pulled 44 joints. Allied pumped 3 sacks hulls, 70 sacks cement, 15 sacks gel, plug and 60 sacks cement.

PLUGGING COMPLETE.

RECEIVED
STATE CORPORATION COMMISSION
JUN - 4 1979

(If additional description is necessary, use BACK of this sheet)
Name of Plugging Contractor KELSO CASING PULLING
CHASE, KANSAS

STATE OF KANSAS COUNTY OF RICE
E. DARRELL KELSO (employee of owner) of (owner or operator)

of the above-described well, being first duly sworn on oath, says: That I have knowledge of the facts, statements, and matters herein contained and the log of the above-described well as filed and that the same are true and correct. So help me God.

(Signature) E. Darrell Kelso
CHASE, KANSAS
(Address)

SUBSCRIBED AND SWORN TO before me this 31st day of May, 19 79

MARGARET MELCHER
Statewide
My Appt. Exp. Feb. 15, 1983

Margaret Melcher
Notary Public.

My commission expires