

15-039-00414-00-00

WELL PLUGGING RECORD

Give All Information Completely
Make Required Affidavit
Mail or Deliver Report to:
Conservation Division
State Corporation Commission
212 North Market, Insurance Bldg.
Wichita, Kansas

Decatur

County. Sec. 29 Twp. 5 Rge. 29 W^(E) (W)

Location as "NE/CNW/SW" or footage from lines 990 f/S Line & 330 f/W line SE/4

Lease Owner Sinclair Oil & Gas Company

Lease Name L. Shaw

Well No. 1

Office Address P. O. Box 466, Chase, Kansas

Character of Well (completed as Oil, Gas or Dry Hole) Dry Hole

Date well completed 10-3-60 19

Application for plugging filed 10-11-60 19

Application for plugging approved 10-14-60 19


Plugging commenced 10-20-60 19

Plugging completed 10-23-60 19

Reason for abandonment of well or producing formation Dry Hole

If a producing well is abandoned, date of last production _____ 19

Was permission obtained from the Conservation Division or its agents before plugging was commenced? Yes

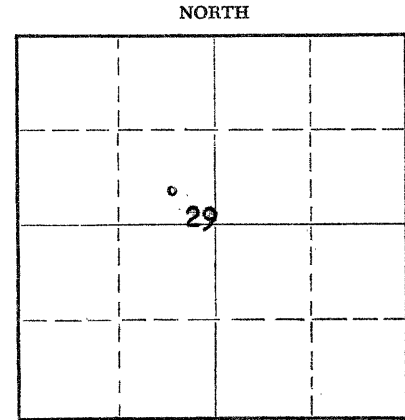

Locate well correctly on above Section Plat

Name of Conservation Agent who supervised plugging of this well A. D. Fabricius

Producing formation _____ Depth to top _____ Bottom _____ Total Depth of Well 4216 Feet

Show depth and thickness of all water, oil and gas formations.

OIL, GAS OR WATER RECORDS

CASING RECORD

FORMATION	CONTENT	FROM	TO	SIZE	PUT IN	PULLED OUT
<u>No producing formations encountered</u>				<u>8-5/8</u>	<u>289</u>	<u>None</u>
				<u>5-1/2"</u>	<u>4114</u>	<u>1441'</u>

Describe in detail the manner in which the well was plugged, indicating where the mud fluid was placed and the method or methods used in introducing it into the hole. If cement or other plugs were used, state the character of same and depth placed, from _____ feet to _____ feet for each plug set.

From TD 4216 to 4079' with cement, from 4079 to 3980' mud with cast iron plug set at 3980', from 3980 to 3902' heavy drlg. mud and cast iron plug set at 3902', from 3902 to 287 with heavy drilling mud, from 287 to 180' with 25 sacks cement, from 180 to 40' with heavy drilling mud, from 40' to ~~surface~~ 30' with rock bridge, from 30' to surface with 10 sacks cement. Hole plugged and abandoned as per Mr. A. D. Fabricius, state inspector's instruction. Completed P&A 10-24-60.

RECEIVED
STATE CORPORATION COMMISSION

NOV 14 1960

CONSERVATION DIVISION
Wichita, Kansas

(If additional description is necessary, use BACK of this sheet)
Name of Plugging Contractor Knight Casing Pulling Company 11-14-60
Address Chase, Kansas

STATE OF Kansas, COUNTY OF Rice, ss.
Cecil B. York (employee of owner) or (owner or operator) of the above-described well, being first duly sworn on oath, says: That I have knowledge of the facts, statements, and matters herein contained and the log of the above-described well as filed and that the same are true and correct. So help me God.

(Signature) C. B. York
Box 466, Chase, Kansas
(Address)

SUBSCRIBED AND SWORN TO before me this 10th day of November, 19 60

My commission expires August 13, 1962
L. B. Reynolds
Notary Public.



15-039-00414-00-00

DRILLERS LOG

NAME OF OPERATOR: Sinclair Oil & Gas Company

NAME OF CONTRACTOR: K & E Drilling Company, Wichita, Kansas

LEASE NAME: L. Shaw - Well # 1

LOCATION: 990' from South line & 330' from West line of SE/4 - Sec. 29-5S-29W
Decatur County, Kansas

<u>From</u>	<u>To</u>	<u>Formation</u>
0	70'	Surface sand and clay
70	145	Water sand
145	200	Shale and blue clay
200	290	Gravel
290	1425	Shale
1425	1765	Shale and shells
1765	1995	Shale and lime
1995	2145	Shale and stks. anhydrites
2145	2232	Shale and red bed
2232	2245	Anhydrite
2245	2497	Shale and shells
2497	2536	Anhydrite
2536	2550	Shale
2550	2760	Shale and shells
2760	3051	Lime and shale
3051	3435	Lime
3435	3525	Lime with shale stks.
3525	3884	Lime
3884	3903	Chert
3903	4056	Lime
4056	4100	Lime and chert
4100	4200	Lime - TD by driller
	4216'	TD - By electric log.

8-5/8" casing set at 290' cement. w/250 sax.
5-1/2" casing set at 3290' Cement. w/250 sax.

RECEIVED
STATE CORPORATION COMMISSION

NOV 14 1960

CONSERVATION DIVISION
Wichita, Kansas

11-14-60