

15-039-00144-00-00

FORM CP-4

STATE OF KANSAS  
STATE CORPORATION COMMISSION  
CONSERVATION DIVISION  
P. O. BOX 17027  
WICHITA, KANSAS 67217

WELL PLUGGING RECORD

Location as "NE/CNW/SW" or footage from lines Decatur County. Sec. 29 Twp. 5 Rge. 29 (E) (X)

Lease Owner Anderson Don C. Rider

Lease Name Anderson Well No. 4410

Office Address 104 W. Lockwood Med. Lodge KANS

Character of Well (completed as Oil, Gas or Dry Hole) Oil Well

Date well completed 12-3- 19 59

Application for plugging filed April 19 75

Application for plugging approved April 19 75

Plugging commenced April 19 75

Plugging completed April 11 19 75

Reason for abandonment of well or producing formation Well Depleted


If a producing well is abandoned, date of last production 5-2 19 74

Was permission obtained from the Conservation Division or its agents before plugging was commenced? yes

Name of Conservation Agent who supervised plugging of this well Lilbert Balthazor

Producing formation LANCING Depth to top 4034 Bottom 4039 Total Depth of Well 4410

Show depth and thickness of all water, oil and gas formations.

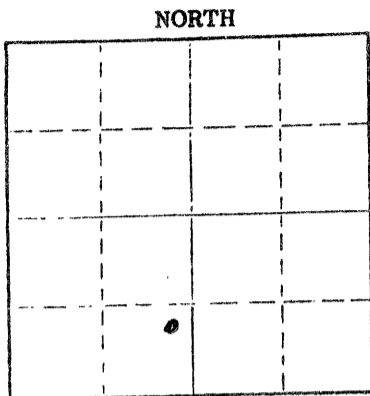

Locate well correctly on above Section Plot

OIL, GAS OR WATER RECORDS

CASING RECORD

FORMATION	CONTENT	FROM	TO	SIZE	PUT IN	PULLED OUT
				8 1/2	250	0
				4 1/2	4110	1700

Describe in detail the manner in which the well was plugged, indicating where the mud fluid was placed and the method or methods used in introducing it into the hole. If cement or other plugs were used, state the character of same and depth placed, from \_\_\_\_\_ feet to \_\_\_\_\_ feet for each plug set.

Plug BK. 3840 w/ SAND & CEMENT.

PIPE CUT @ 1708

PUMP w/ ALLIED CEMENT DOWN - 85'

2 SX HULLS - 10 SX LEL. 20 SX 59-60 POT - 62 1/2' & 20 SX LEL

1 SX HULLS & 50 SX CEMENT ON TOP. MAX. PRES - 250#

(If additional description is necessary, use BACK of this sheet)

Name of Plugging Contractor \_\_\_\_\_

Address \_\_\_\_\_

STATE OF \_\_\_\_\_ COUNTY OF \_\_\_\_\_, SS.

\_\_\_\_\_, (employee of owner) or (owner or operator) of the above-described well, being first duly sworn on oath, says: That I have knowledge of the facts, statements, and matters herein contained and the log of the above-described well as filed and that the same are true and correct. So help me God.

(Signature) Don C. Rider

(Address)

Subscribed and sworn to before me this \_\_\_\_\_ day of \_\_\_\_\_, 19 \_\_\_\_\_

My commission expires \_\_\_\_\_

Notary Public.

RECEIVED  
STATE CORPORATION COMMISSION

SEP 16 1975

9-16-75

CONSERVATION DIVISION  
Wichita, Kansas