

STATE CORPORATION COMMISSION OF KANSAS  
OIL & GAS CONSERVATION DIVISION

WELL COMPLETION OR RECOMPLETION FORM  
ACO-1 WELL HISTORY

DESCRIPTION OF WELL AND LEASE

Operator: license # 9123  
name Diamond Shamrock Exploration Co.  
address P. O. Box 400  
City/State/Zip Amarillo, Texas 79188-0001

Operator Contact Person Todd Lovett  
Phone 806/378-3848

Contractor: license # 5418  
name Allen Drlg. Co.

Wellsite Geologist Doug Davis  
Phone 316/264-7464

Designate Type of Completion

New Well  Re-Entry  Workover

Oil  SWD  Temp Abd  Delayed Comp.  
 Gas  Inj  Other (Core, Water Supply etc.)  
 Dry

If OWWO: old well info as follows:

Operator  
Well Name  
Comp. Date Old Total Depth

WELL HISTORY

Drilling Method:  Mud Rotary  Air Rotary  Cable

12-14-84 12-20-84 12-22-84  
Spud Date Date Reached TD Completion Date  
3820 --  
Total Depth PBTD

Amount of Surface Pipe Set and Cemented at 330 feet

Multiple Stage Cementing Collar Used?  Yes  No

If Yes, Show Depth Set feet

If alternate 2 completion, cement circulated  
from Surf. feet depth to 330 w/ 250 SX cmt

API NO. 15-059-20,755-00-00  
County Decatur  
NW NE SE Sec 6 Twp 5S Rge 26  
2310 Ft North from Southeast Corner of Section  
990 Ft West from Southeast Corner of Section  
(Note: locate well in section plat below)


Lease Name Owen Boyles Well# 1-6

Field Name N/A

Producing Formation

Elevation: Ground 2589' KB 2595  
Kc-Kcc

Section Plat

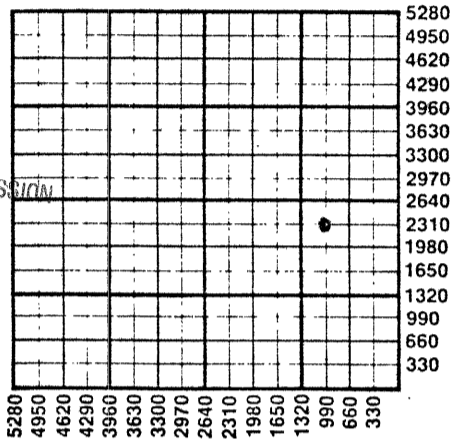

RECEIVED  
STATE CORPORATION COMMISSION  
JAN 24 1985  
CONSERVATION DIVISION  
Wichita, Kansas  
124-85

WATER SUPPLY INFORMATION

Source of Water: Not available  
Division of Water Resources Permit #

Groundwater Ft North From Southeast Corner and  
(Well) Ft. West From Southeast Corner of  
Sec Twp Rge  East  West

Surface Water Ft North From Southeast Corner and  
(Stream, Pond etc.) Ft West From Southeast Corner  
Sec Twp Rge  East  West

Other (explain)  
(purchased from city, R.W.D.#)

Disposition of Produced Water:  Disposal  Repressuring

Docket #

INSTRUCTIONS: This form shall be completed in duplicate and filed with the Kansas Corporation Commission, 200 Colorado Derby Building, Wichita, Kansas 67202, within 90 days after completion or recompletion of any well. Rules 82-3-130 and 82-3-107 apply.

Information on side two of this form will be held confidential for a period of 12 months if requested in writing and submitted with the form. See rule 82-3-107 for confidentiality in excess of 12 months.

One copy of all wireline logs and drillers time log shall be attached with this form. Submit CP-4 form with all plugged wells. Submit CP-111 form with all temporarily abandoned wells.

All requirements of the statutes, rules, and regulations promulgated to regulate the oil and gas industry have been fully complied with and the statements herein are complete and correct to the best of my knowledge.

Signature Todd Lovett

Title Drlg. Engineer Date 1-18-85

Subscribed and sworn to before me this 18 day of January 19 85

Notary Public Patti Jones

Date Commission Expires 5-06-85 Patti Jones

K.C.C. OFFICE USE ONLY  
F  Letter of Confidentiality Attached  
C  Wireline Log Received  
C  Drillers Timelog Received  
Distribution  
 KCC  SWD/Rep  NGPA  
 KGS  Plug  Other  
(Specify)

Form ACO-1  
(This form supercedes  
previous forms  
ACO-1 & C-10)

Sec. 10 Twp. 5 S. Rge. 26 W

**WELL LOG**

**INSTRUCTIONS:** Show important tops and base of formations penetrated. Detail all cores. Report all drill stem tests giving interval tested, time tool open and closed, flowing and shut-in pressures, whether shut-in pressure reached static level, hydrostatic pressures, bottom hole temperature, fluid recovery, and flow rates if gas to surface during test. Attach extra sheet if more space is needed. Attach copy of log.

Drill Stem Tests Taken  Yes  No  
 Samples Sent to Geological Survey  Yes  No  
 Cores Taken  Yes  No

**Formation Description**  
 Log  Sample

DST#1 - 3642-3725, 30/60/30/60. 1st open-strong blow to bottom of bucket in 22 min. FP 100/130 SIP 1078. 2nd. open sam as 1st. FP 160/190, SIP 1059. Rec. 280' muddy salt water.

Name	Top	Bottom
Stone Corral	2144	
Heebner	3530	
Toronto	3556	
Lansing	3572	
L/KC "B"	3598	
L/KC "E"	3645	
L/KC "G"	3675	
B/KC	3758	

CASING RECORD <input checked="" type="checkbox"/> new <input type="checkbox"/> used							
Report all strings set - conductor, surface, intermediate, production, etc.							
Purpose of string	size hole drilled	size casing set (in O.D.)	weight lbs/ft.	setting depth	type of cement	# sacks used	type and percent additives
Surface	12 1/4	8 5/8	24#	330	Howco	250	2% gel, 3%cc
PERFORATION RECORD				Acid, Fracture, Shot, Cement Squeeze Record			
shots per foot	specify footage of each interval perforated			(amount and kind of material used)			Depth
TUBING RECORD				Liner Run <input type="checkbox"/> Yes <input type="checkbox"/> No			
Date of First Production		Producing method <input type="checkbox"/> flowing <input type="checkbox"/> pumping <input type="checkbox"/> gas lift <input type="checkbox"/> Other (explain)					
Estimated Production Per 24 Hours	Oil	Gas	Water	Gas-Oil Ratio	Gravity		
	Bbls	MCF	Bbls	CFPB			

Disposition of gas:  vented  sold  used on lease

**METHOD OF COMPLETION**  
 open hole  perforation  other (specify) .....

**PRODUCTION INTERVAL**  
 Dually Completed.  
 Commingled