

CARD MUST BE TYPED

State of Kansas

CARD MUST BE SIGNED

NOTICE OF INTENTION TO DRILL

(see rules on reverse side)

Collector
10-3186

Starting Date Nov. 4. 1986
month day year

API Number 15— 153-20,674-00-00

OPERATOR: License # 9152

..... East
C. NW SW Sec. 31 Twp. 5 S, Rg. 36 X West

Name MAREXCO

..... Ft. from South Line of Section

Address 10403 W. Colfax Ave., #680

..... 1980

City/State/Zip Lakewood, CO 80215

..... 4620

Contact Person Stephen W. Marden

(Note: Locate well on Section Plat on reverse side)

Phone (303) 237-5716

Nearest lease or unit boundary line 660 feet

* CONTRACTOR: License # [REDACTED]

County Rawlins

Name [REDACTED]

Lease Name Towrea Well # 13-31

City/State [REDACTED] CO

Ground surface elevation 3,417 feet MSL

Well Drilled For: Well Class: Type Equipment:

Domestic well within 330 feet: — yes X no

X Oil — SWD — Infield X Mud Rotary

Municipal well within one mile: — yes X no

— Gas — Inj X Pool Ext. — Air Rotary

Surface pipe by Alternate: 1 X 2

— OWWO — Expl — Wildcat — Cable

Depth to bottom of fresh water 325

If OWWO: old well info as follows:

Depth to bottom of usable water 375

Operator

Surface pipe planned to be set 400'

Well Name

Projected Total Depth 4,800 feet

Comp Date Old Total Depth

Formation Cherokee

I certify that well will comply with K.S.A. 55-101, et seq., plus eventually plugging hole to KCC specifications.

cementing will be done immediately upon setting production casing.

Date 10/27/86 Signature of Operator or Agent Stephen W. Marden Title owner

For KCC Use:

Conductor Pipe Required feet; Minimum Surface Pipe Required 375 feet per Alt. 100'

This Authorization Expires 1-30-87 Approved By 10-30-86

Must be filed with the K.C.C. five (5) days prior to commencing well
 This card void if drilling not started within six (6) months of date received by K.C.C.


RECEIVED
 STATE CORPORATION COMMISSION
 CONSERVATION DIVISION
 WICHITA, KANSAS

Important procedures to follow:

1. Notify District office before setting surface casing.
2. Set surface casing by circulating cement to the top.
3. File completion forms ACO-1 with K.C.C. within 90 days of well completion, following instructions on ACO-1, side 1, and including copies of wireline logs.
4. Notify District office 48 hours prior to old well workover or re-entry.
5. Prior to filing Intent, prepare a proposed plugging plan in case well is D & A, then obtain approval of plan when calling district office prior to setting surface pipe.
6. Submit plugging report (CP-4) to K.C.C. after plugging is completed.
7. Obtain an approved injection docket number before disposing of salt water.
8. Notify K.C.C. within 10 days when injection commences or terminates.
9. If an alternate 2 completion, cement in the production pipe from below any usable water to surface within 120 days of spud date.

A Regular Section of Land
 1 Mile = 5,280 Ft.

10-30-86
 OCT 30 1988

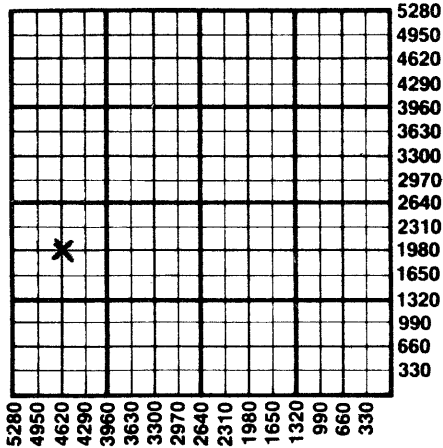

State Corporation Commission of Kansas
 Conservation Division
 200 Colorado Derby Building
 Wichita, Kansas 67202
 (316) 263-3238