

JUN - 4 1981


6-4-81
CONSERVATION DIVISION
WELL PLUGGING RECORD
Wichita, Kansas

15-023-20176-02

STATE OF KANSAS
STATE CORPORATION COMMISSION

Give All Information Completely
Make Required Affidavit
Mail or Deliver Report to
Conservation Division
State Corporation Comm.
245 North Water
Wichita, KS 67202

Cheyenne County, Sec. 32 Twp. 5S. Rge. 41 E/W
Location as "NE/CNW $\frac{1}{4}$ SW $\frac{1}{4}$ " or footage from lines
660' FSL & 1980' FWL (SE $\frac{1}{4}$ SW $\frac{1}{4}$)
Lease Owner Alexander & Ambrose Oil Corporation
Lease Name William J. Peterson Well No. 1-32
Office Address 1675 Broadway, Suite 2380
Denver, Colorado 80202
Character of Well (Completed as Oil, Gas or Dry Hole)
Dry Hole

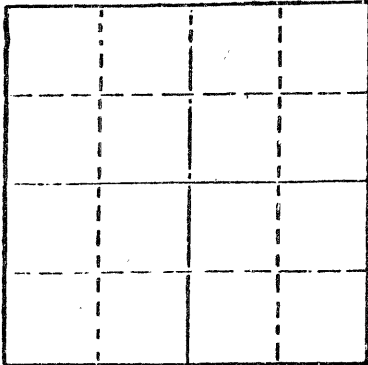

Locate well correctly on above
Section Plat

Date Well completed April 28, 1981
Application for plugging filed April 28, 1981
Application for plugging approved April 28, 1981
Plugging commenced April 28, 1981
Plugging completed April 28, 1981
Reason for abandonment of well or producing formation
Non-Commercial
If a producing well is abandoned, date of last production
19

Was permission obtained from the Conservation Division or
its agents before plugging was commenced? Yes

Name of Conservation Agent who supervised plugging of this well Gilbert Balthazor
Producing formation Niobrara Depth to top 1612 Bottom TD Total Depth of Well 1746
Show depth and thickness of all water, oil and gas formations.

OIL, GAS OR WATER RECORDS

CASING RECORD

FORMATION	CONTENT	FROM	TO	SIZE	PUT IN	PULLED OUT
Surface to Pierre	Water	0	240'	7-5/8"	305'	--
Pierre to Niobrara	--	240'	1612'	--	--	--
Niobrara to T.D.	--	1612'	1746'	--	--	--

Describe in detail the manner in which the well was plugged, indicating where the mud fluid
was placed and the method or methods used in introducing it into the hold. If cement or other
plugs were used, state the character of same and depth placed, from _____ feet to
_____ feet for each plug set. Hole full of mud before plugging commenced.
60 sx of reg. cement were spotted from 1700' to 1370', 30 sx from 360' to
300' at base of surface casing and 10 sx @ 40' from surface.

(If additional description is necessary, use BACK of this sheet)

Name of Plugging Contractor Teton Exploration Drilling Co., Inc.

STATE OF Colorado COUNTY OF Denver, ss.

Benjamin C. Stromberg, Jr. (employee of owner) or (owner or operator)
of the above-described well, being first duly sworn on oath, says: That I have knowledge of
the facts, statements, and matters herein contained and the log of the above-described well
as filed and that the same are true and correct. So help me God.

(Signature)

1675 Broadway, Suite 2380, Denver, Co.
(Address) 80202

SUBSCRIBED AND SWORN TO before me this 1st day of June, 1981.

My commission expires My Commission Expires Feb. 23, 1983

Anna M. Lietzan
Anna M. Lietzan Notary Public.