

15-023-20114-00-00

STATE OF KANSAS
STATE CORPORATION COMMISSION

WELL PLUGGING RECORD

Give All Information Completely
Make Required Affidavit
Mail or Deliver Report to
Conservation Division
State Corporation Comm.
245 North Water
Wichita, KS 67202

Cheyenne County. Sec. 29 Twp. 5S Rge. 41 E/W
Location as "NE/CNW $\frac{1}{4}$ SW $\frac{1}{4}$ " or footage from lines
1320' FNL - 1520' FEL

Lease Owner Midlands Gas Corporation
Lease Name Pfeifer/McGowan Well No. 1-29

Office Address P.O. Box 15265, Lakewood, CO 80215

Character of Well (Completed as Oil, Gas or Dry Hole) Dry Hole

Date Well completed 1/11/80 1980

Application for plugging filed 1/15 1980

Application for plugging approved _____ 19

Plugging commenced 1/11/80 1980

Plugging completed 1/11/80 1980

Reason for abandonment of well or producing formation Dry Hole


If a producing well is abandoned, date of last production _____ 19

Was permission obtained from the Conservation Division or its agents before plugging was commenced? yes

Name of Conservation Agent who supervised plugging of this well Gilbert Balthazar

Producing formation N/A Depth to top _____ Bottom _____ Total Depth of Well 1805'

Show depth and thickness of all water, oil and gas formations.

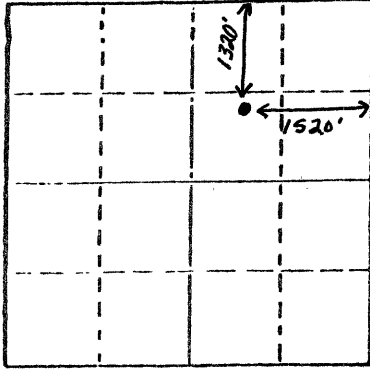

Locate well correctly on above Section Plat

OIL, GAS OR WATER RECORDS

CASING RECORD

FORMATION	CONTENT	FROM	TO	SIZE	PUT IN	PULLED OUT

Describe in detail the manner in which the well was plugged, indicating where the mud fluid was placed and the method or methods used in introducing it into the hold. If cement or other plugs were used, state the character of same and depth placed, from _____ feet to _____ feet for each plug set.

70 sx 50-50 poz 1800' to 1540'

20 sx 50-50 poz 360' to 285'

10 sx 50-50 poz 40' to 5'

5 sx Rathole

STATE RECEIVED
JAN 21 1980
CONSERVATION DIVISION
WICHITA, KANSAS

(If additional description is necessary, use BACK of this sheet)

Name of Plugging Contractor Halliburton Services 1-21-80

STATE OF Colorado COUNTY OF Yuma, ss.
Thomas B. Abbott (employee of owner) or (~~owner or operator~~)

of the above-described well, being first duly sworn on oath, says: That I have knowledge of the facts, statements, and matters herein contained and the log of the above-described well as filed and that the same are true and correct. So help me God.

(Signature) Thomas B Abbott

P.O. Box 442, Wray, Colorado 80758
(Address)

SUBSCRIBED AND SWORN TO before me this 16th day of January, 19 80

Janice E Spelts
Notary Public.

My commission expires August 15, 1982

