

15-023-20119-00-00


FORM CP-4

STATE OF KANSAS
STATE CORPORATION COMMISSION

WELL PLUGGING RECORD

Give All Information Completely
Make Required Affidavit
Mail or Deliver Report to
Conservation Division
State Corporation Comm.
245 North Water
Wichita, KS 67202

Cheyenne County. Sec. 30 Twp. 5S Rge. 40 E/W
Location as "NE/CNW 1/4 SW 1/4" or footage from lines 1320' FNL
1320' FEL
Lease Owner Midlands Gas Corporation
Lease Name Heaton Well No. #1-30
Office Address Box 6 Wray, CO 80758
Character of Well (Completed as Oil, Gas or Dry Hole) _____

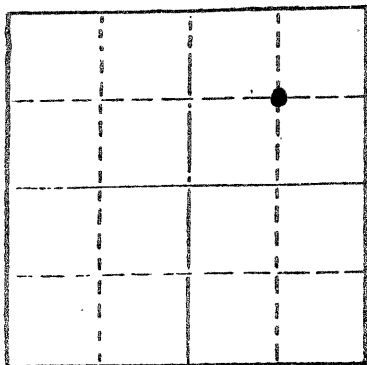

Locate well correctly on above
Section Plat

Dry Hole
Date Well completed 6/2 19 80
Application for plugging filed 8/25 19 80
Application for plugging approved verbal approval 6/2 19 80
Plugging commenced 6/2/80 19
Plugging completed 6/2 19 80
Reason for abandonment of well or producing formation _____
lack of gas show
If a producing well is abandoned, date of last production _____
19 _____

Was permission obtained from the Conservation Division or
its agents before plugging was commenced? yes Balthazor

Name of Conservation Agent who supervised plugging of this well verbal permission - Gilbert
Producing formation Niobrara Depth to top 1499 Bottom 1536 Total Depth of Well 1802'
Show depth and thickness of all water, oil and gas formations.

OIL, GAS OR WATER RECORDS

CASING RECORD

FORMATION	CONTENT	FROM	TO	SIZE	PUT IN	PULLED OUT
				7 5/8"	333'	none

Describe in detail the manner in which the well was plugged, indicating where the mud fluid
was placed and the method or methods used in introducing it into the hold. If cement or other
plugs were used, state the character of same and depth placed, from _____ feet to
_____ feet for each plug set.

60 sx class G cement @ 1300', 20 sx class G cement at 335', and 10 sx class G cement at 60'

(If additional description is necessary, use BACK of this sheet)

Name of Plugging Contractor Cementer Inc. - Scottsbluff, NE

RECEIVED
STATE CORPORATION COMMISSION
8-29-80
AUG 29 1980
CONSERVATION DIVISION
Wichita, Kansas

STATE OF Colorado COUNTY OF Yuma
Don Gretch (employee of owner) of _____
of the above-described well, being first duly sworn on oath, says: I have knowledge of
the facts, statements, and matters herein contained and the log of the above described well
as filed and that the same are true and correct. So help me God.

(Signature) Don Gretch
Box 6 Wray, CO 80758
(Address)

SUBSCRIBED AND SWORN TO before me this 26th day of August, 1980

Janice E. Speltz
Notary Public.

My commission expires August 15, 1982