

15-023-20149-00-00

STATE OF KANSAS
STATE CORPORATION COMMISSION

WELL PLUGGING RECORD

Give All Information Completely
Make Required Affidavit
Mail or Deliver Report to
Conservation Division
State Corporation Comm.
245 North Water
Wichita, KS 67202

Cheyenne County. Sec. 3 Twp. 5 Rge. 40 E/W
Location as "NE/CNW $\frac{1}{4}$ SW $\frac{1}{4}$ " or footage from lines
1320' FSL 1320' FWL

Lease Owner Nielson Enterprises Inc.
Lease Name Boardman Well No. 1

Office Address 2770 - 1675 Broadway, Denver, Colorado 80202
Character of Well (Completed as Oil, Gas or Dry Hole)

Dry Hole

Date Well completed 9/27 1980

Application for plugging filed 9/27 1980

Application for plugging approved 9/27 1980


Plugging commenced 9/27 1980

Plugging completed 9/27 1980

Reason for abandonment of well or producing formation
Dry Hole

If a producing well is abandoned, date of last production
19

Was permission obtained from the Conservation Division or
its agents before plugging was commenced? Yes

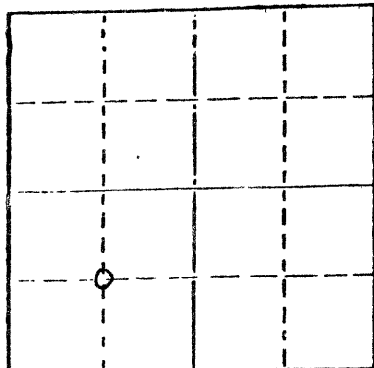

Locate well correctly on above
Section Plat

Name of Conservation Agent who supervised plugging of this well Gilbert Balthazor
Producing formation --- Depth to top --- Bottom --- Total Depth of Well 1609'
Show depth and thickness of all water, oil and gas formations.

OIL, GAS OR WATER RECORDS

CASING RECORD

| FORMATION | CONTENT | FROM | TO | SIZE | PUT IN | PULLED OUT |
|-----------|---------|----------|----------|------|--------|------------|
| Niobrara | Dry | 1494' KB | 1534' KB | 7" | 336' | 0' |
| | | | | | | |
| | | | | | | |
| | | | | | | |

Describe in detail the manner in which the well was plugged, indicating where the mud fluid
was placed and the method or methods used in introducing it into the hold. If cement or other
plugs were used, state the character of same and depth placed, from feet to
feet for each plug set.

| Depth | Amount | Cementing Material |
|--------|----------|--------------------|
| Bottom | 50 sacks | 50/50 Poz 2% gel |
| 300' | 20 sacks | 50/50 Poz 2% gel |
| 40' | 10 sacks | 50/50 Poz 2% gel |

Surface casing was cut off and welded shut 4' below surface.

(If additional description is necessary, use BACK of this sheet)

Name of Plugging Contractor Halliburton

STATE OF Colorado COUNTY OF Adams, ss.
Dean K. Wallace (employee of owner) xxx (owner) xxx (operator) xxx

of the above-described well, being first duly sworn on oath, says: That I have knowledge of
the facts, statements, and matters herein contained and the log of the above-described well
as filed and that the same are true and correct. So help me God.

(Signature)

Dean K. Wallace

(Address)

SUBSCRIBED AND SWORN TO before me this 14th day of October, 1980

Judith L. Utz

Notary Public.

My commission expires My commission expires Dec. 20, 1981

RECEIVED
STATE CORPORATION COMMISSION

OCT 17 1980

CONSERVATION DIVISION
Wichita, Kansas

10-17-80