

15-039-20383-00-00

STATE OF KANSAS
STATE CORPORATION COMMISSION

WELL PLUGGING RECORD

Give All Information Completely
Make Required Affidavit
Mail or Deliver Report to
Conservation Division
State Corporation Comm.
245 North Water
Wichita, KS 67202

Decatur County, Sec. 21 Twp. 5S Rge. 30W E/W
Location as "NE/CNW $\frac{1}{4}$ SW $\frac{1}{4}$ " or footage from lines

C NW SE

Lease Owner A. L. Abercrombie, Inc.

Lease Name ROBERTSON Well No. 4

Office Address 801 Union Center, Wichita, Ks. 67202

Character of Well (Completed as Oil, Gas or Dry Hole)
Dry Hole

Date Well completed 2-16 1977

Application for plugging filed (Verbally) 2-16 1977

Application for plugging approved (Verbally) 2-16 1977

Plugging commenced 2-16 1977

Plugging completed 2-16 1977

Reason for abandonment of well or producing formation

No commercial quantity of oil or gas encountered


If a producing well is abandoned, date of last production
19

Was permission obtained from the Conservation Division or
its agents before plugging was commenced? Yes

Name of Conservation Agent who supervised plugging of this well Gilbert Balthazor

Producing formation Depth to top Bottom Total Depth of Well

Show depth and thickness of all water, oil and gas formations.

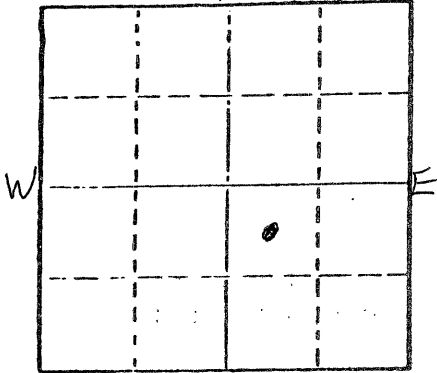

Locate well correctly on above
Section Plot

OIL, GAS OR WATER RECORDS

CASING RECORD

| FORMATION | CONTENT | FROM | TO | SIZE | PUT IN | PULLED OUT |
|-----------|---------|------|----|------|--------|------------|
| | | | | | | |
| | | | | | | |
| | | | | | | |
| | | | | | | |

Describe in detail the manner in which the well was plugged, indicating where the mud fluid was placed and the method or methods used in introducing it into the hold. If cement or other plugs were used, state the character of same and depth placed, from feet to feet for each plug set.

T.D. 4109'
Set 1st plug at 1600' with 70 sx.,
2nd plug at 250' with 20 sx.
40' solid bride with 10 sx.

Plug was down at 8:00 p.m. 2-16-77
State Plugger - Gilbert Balthazor

RECEIVED
STATE CORPORATION COMMISSION

FEB 24 1977
02-24-1977

(If additional description is necessary, use BACK of this sheet)

Name of Plugging Contractor Abercrombie Drilling, Inc.

STATE OF Kansas COUNTY OF Sedgwick ss.
Jack L. Partridge, Asst. Sec.-Treas. (employee of owner) or (owner or operator) of the above-described well, being first duly sworn on oath, says: That I have knowledge of the facts, statements, and matters herein contained and the log of the above-described well as filed and that the same are true and correct. So help me God.

(Signature) *Jack L. Partridge*
801 Union Center, Wichita, Kansas 67202
(Address)

Subscribed and Sworn to before me this 22nd day of February 1977

My commission expires _____
Kathy S. Goertz
Kathy S. Goertz Notary Public

