

Give All Information Completely  
Make Required Affidavit  
Mail or Deliver Report to:  
Conservation Division  
State Corporation Commission  
800 Bittling Building  
Wichita, Kansas

WELL PLUGGING RECORD

15-029-00084-00-00

DECATUR

County. Sec. 17 Twp. 5 Rge. 30 (E) W (W)

Location as "NE/CNW/SE/SW" or footage from lines SE, SE, SW

Lease Owner DERBY OIL CO.

Lease Name SKILES Well No. 1

Office Address 420 WEST DOUGLAS, WICHITA, KANSAS

Character of Well (completed as Oil, Gas or Dry Hole) DRY HOLE

Date well completed 10-13 19 54

Application for plugging filed 10-13 19 54

Application for plugging approved 10-13 19 54


Plugging commenced 10-13 19 54

Plugging completed 10-13 19 54

Reason for abandonment of well or producing formation DRY HOLE

If a producing well is abandoned, date of last production 19

Was permission obtained from the Conservation Division or its agents before plugging was commenced? Yes

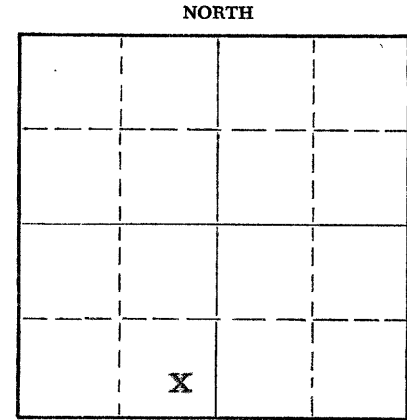

Locate well correctly on above Section Plat

Name of Conservation Agent who supervised plugging of this well ELDON PETTY

Producing formation Depth to top Bottom Total Depth of Well 4600 Feet

Show depth and thickness of all water, oil and gas formations.

OIL, GAS OR WATER RECORDS

CASING RECORD

FORMATION	CONTENT	FROM	TO	SIZE	PUT IN	PULLED OUT
				8 5/8	348	0

Describe in detail the manner in which the well was plugged, indicating where the mud fluid was placed and the method or methods used in introducing it into the hole. If cement or other plugs were used, state the character of same and depth placed, from feet to feet for each plug set.

HOLE WAS FILLED WITH HEAVY MUD TO 240 FEET. PLUG WAS SET AND 15 SACKS OF CEMENT WERE HAND MIXED AND PUT ON TOP OF THE PLUG, THROUGH THE DRILL PIPE, NO PLUG WAS SET AT TOP OF SURFACE PIPE, AS HOLE WAS LEFT AS A WATER WELL FOR MR. SKILES. PERMISSION WAS GRANTED BY ELDON PETTY TO DO THIS.

(If additional description is necessary, use BACK of this sheet)

Name of Plugging Contractor SCHAFFER DRILLING COMPANY

Address BOX 350-----Pratt, Kansas

STATE OF KANSAS, COUNTY OF PRATT, ss.

J. E. SELBY (employee of owner) or (owner or operator) of the above-described well, being first duly sworn on oath, says: That I have knowledge of the facts, statements, and matters herein contained and the log of the above-described well as filed and that the same are true and correct. So help me God.

(Signature) J. E. Selby

PRATT, KANSAS


(Address)

SUBSCRIBED AND SWORN TO before me this 15th day of OCTOBER, 19 54

Maudie B McBride

My commission expires 6-30-55

Notary Public.

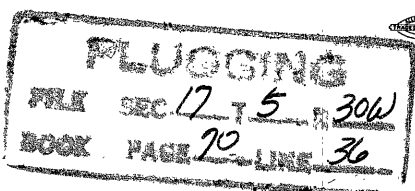

10-22-1954