


15-039-20318-00-00

FORM CP-4

STATE OF KANSAS
STATE CORPORATION COMMISSION
CONSERVATION DIVISION
P. O. BOX 17027
WICHITA, KANSAS 67217

WELL PLUGGING RECORD

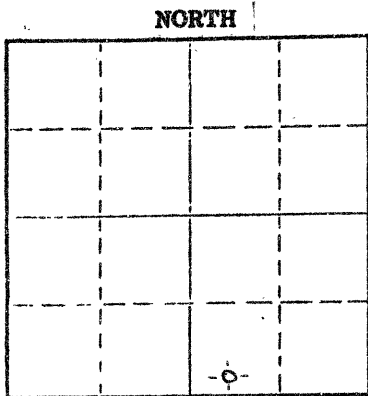

Locate well correctly on above Section Plat

Decatur County, Sec. 16 Twp. 5 Rge. 30 (X) (W)
Location as "NE/CNW/SW" or footage from lines C S/2 SW SE
Lease Owner West Kansas Oil Corporation
Lease Name Showers Well No. 1
Office Address P.O. Box 818, McCook, Nebraska 69001
Character of Well (completed as Oil, Gas or Dry Hole) Dry Hole
Date well completed 4-8-76 19
Application for plugging filed 4-8 19 76
Application for plugging approved 4-8 (verbally) 19 76
Plugging commenced 4-8 19 76
Plugging completed 4-8 19 76
Reason for abandonment of well or producing formation commercial quantities of oil not found
If a producing well is abandoned, date of last production 19
Was permission obtained from the Conservation Division or its agents before plugging was commenced? Yes

Name of Conservation Agent who supervised plugging of this well Gilbert Balthazor - Palco, Kansas
Producing formation _____ Depth to top _____ Bottom _____ Total Depth of Well 4200 Feet
Show depth and thickness of all water, oil and gas formations.

OIL, GAS OR WATER RECORDS

CASING RECORD

FORMATION	CONTENT	FROM	TO	SIZE	PUT IN	PULLED OUT
				8 5/8"	232	None

Describe in detail the manner in which the well was plugged, indicating where the mud fluid was placed and the method or methods used in introducing it into the hole. If cement or other plugs were used, state the character of same and depth placed, from _____ feet to _____ feet for each plug set.

Drilling mud (9.6 ppg) from 1500' to 4200'
Cement - 70 sacks from 1290' to 1500'
Drilling mud (9.6 ppg) from 230' to 1290'
Cement 20 sacks from 170' to 230'
Drilling mud from 40' to 170'
Cement - 10 sacks from 5' to 40'
Cemented rat hole
Mud and cement placed through drill pipe


(If additional description is necessary, use BACK of this sheet)
Name of Plugging Contractor Sun Oil Well Cementing
Address Box 169, Great Bend, Kansas 67530

STATE OF NEBRASKA COUNTY OF RED WILLOW
M. E. Carr (employee of owner) or (XXXXXXXXXX) of the above-described well, being first duly sworn on oath, says: That I have knowledge of the facts, statements, and matters herein contained and the log of the above-described well as filed and that the same are true and correct. So help me God.

(Signature) *M. Carr*
P.O. Box 818, McCook, Nebraska 69001
(Address)

SUBSCRIBED AND SWORN TO before me this 12th day of April 1976

My commission expires

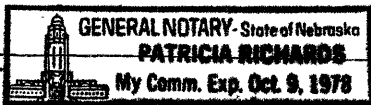

Notary Public

RECEIVED
STATE CORPORATION COMMISSION
APR 19 1976
04-19-1976
CONSERVATION DIVISION
Wichita, Kansas