


15-023-20009-0000

STATE OF KANSAS  
STATE CORPORATION COMMISSION  
CONSERVATION DIVISION  
P. O. BOX 17027  
WICHITA, KANSAS 67217

FORM CP-4

WELL PLUGGING RECORD

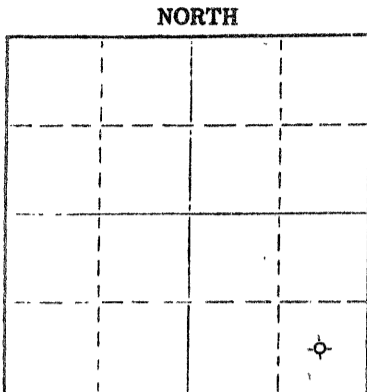

Locate well correctly on above Section Plat

Cheyenne County. Sec. 34 Twp. 5 Rge. (E) 39 (W)  
Location as "NE/CNW&SW¼" or footage from lines. C SE SE  
Lease Owner Mountain Petroleum Corp.  
Lease Name Murray Well No. 1-34  
Office Address 712 Denver Center Bldg. 1776 Lincoln Denver, Co  
Character of Well (completed as Oil, Gas or Dry Hole) Dry hole 80203  
Date well completed 5/6 1975  
Application for plugging filed 6/5 1975  
Application for plugging approved 5/13 1975  
Plugging commenced 5/6 1975  
Plugging completed 5/6 1975  
Reason for abandonment of well or producing formation dry hole

If a producing well is abandoned, date of last production --- 19  
Was permission obtained from the Conservation Division or its agents before plugging was commenced? No; field personnel could not locate Conservation Agent

Name of Conservation Agent who supervised plugging of this well \_\_\_\_\_  
Producing formation \_\_\_\_\_ Depth to top \_\_\_\_\_ Bottom \_\_\_\_\_ Total Depth of Well \_\_\_\_\_ Feet  
Show depth and thickness of all water, oil and gas formations.

OIL, GAS OR WATER RECORDS

CASING RECORD

FORMATION	CONTENT	FROM	TO	SIZE	PUT IN	PULLED OUT
		surface	340'	7 5/8"	340'	none

Describe in detail the manner in which the well was plugged, indicating where the mud fluid was placed and the method or methods used in introducing it into the hole. If cement or other plugs were used, state the character of same and depth placed, from \_\_\_\_\_ feet to \_\_\_\_\_ feet for each plug set.

Plugs:

- 25 sacks at 1400'
- 15 sacks at 340' (bottom of surface casing)
- 5 sacks at top of surface casing.

(If additional description is necessary, use BACK of this sheet)

Name of Plugging Contractor Western Well Drilling  
Address 11299 Old Brighton Road, Henderson, Colorado 80640

STATE OF Colorado COUNTY OF Denver  
John P. Lockridge

(employee of owner) or (owner or operator) of the above-described well, being first duly sworn on oath, says: That I have knowledge of the facts, statements, and matters herein contained and the log of the above-described well as filed and that the same are true and correct. So help me God.

(Signature) John P. Lockridge  
712 Denver Center, Denver, CO. 80203  
(Address)

SUBSCRIBED AND SWORN TO before me this 6th day of June 1975

My commission expires April 28, 1977

Sharon R. Bouldin  
Sharon R. Bouldin Notary Public.

RECEIVED  
STATE CORPORATION COMMISSION

JUN 9 1975

CONSERVATION DIVISION  
Wichita, Kansas

6-9-75