

15-023-20183-00-00

STATE OF KANSAS
STATE CORPORATION COMMISSION


RECEIVED FEB 1 1982

WELL PLUGGING RECORD

Give All Information Completely
Make Required Affidavit
Mail or Deliver Report to
Conservation Division
State Corporation Comm.
245 North Water
Wichita, KS 67202

Cheyenne County. Sec. 36 Twp. 5S Rge. 37 xR/W
Location as "NE/CNW $\frac{1}{4}$ SW $\frac{1}{4}$ " or footage from lines SW SE

Lease Owner Nielson Enterprises, Inc.
Lease Name McKee "E" Well No. #1
Office Address 1675 Broadway - Suite 2770, Denver, CO. 80202
Character of Well (Completed as Oil, Gas or Dry Hole) Dry Hole

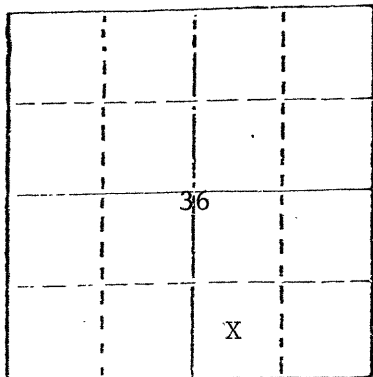

Locate well correctly on above Section Plot

Date Well completed 1-27-82 19
Application for plugging filed 1-27-82 19
Application for plugging approved 1-27-82 19
Plugging commenced 1-27-82 19
Plugging completed 1-27-82 19

Reason for abandonment of well or producing formation Commercial quantities of oil not found
If a producing well is abandoned, date of last production 19

Was permission obtained from the Conservation Division or its agents before plugging was commenced? Yes

Name of Conservation Agent who supervised plugging of this well _____
Producing formation _____ Depth to top _____ Bottom _____ Total Depth of Well 4850'
Show depth and thickness of all water, oil and gas formations.

OIL, GAS OR WATER RECORDS

CASING RECORD

FORMATION	CONTENT	FROM	TO	SIZE	PUT IN	PULLED OUT
				8 5/8"	367'	None

Describe in detail the manner in which the well was plugged, indicating where the mud fluid was placed and the method or methods used in introducing it into the hold. If cement or other plugs were used, state the character of same and depth placed, from _____ feet to _____ feet for each plug set.

- Plug @ 2150' w/70 sx.
- Plug @ 350' w/40 sx.
- Plug @ 40' w/10 sx.
- Rat Hole 10 sx.

(If additional description is necessary, use BACK of this sheet)

Name of Plugging Contractor Rains & Williamson Oil Co., Inc.

STATE OF Kansas COUNTY OF Sedgwick, ss.

Wilson Rains, President of Rains & Williamson Oil Co., (employee of owner) or (owner or operator) of the above-described well, being first duly sworn on oath, says: That I have knowledge of the facts, statements, and matters herein contained and the log of the above-described well as filed and that the same are true and correct. So help me God.

(Signature) Wilson Rains
435 Page Court, 220 W. Douglas, Wichita, Ks. 67202
(Address)

SUBSCRIBED AND SWORN TO before me this 29 day of January, 1982



Juanita M. Green
Deputy Public.
STATE CORPORATION COMMISSION

RECEIVED
FEB - 4 1982
CONSERVATION DIVISION
Wichita, Kansas

2-4-82