

KANSAS CORPORATION COMMISSION
OIL & GAS CONSERVATION DIVISION
WELL PLUGGING APPLICATION
Please TYPE Form and File ONE Copy

Form CP-1
September 2003
This Form must be Typed
Form must be Signed
All blanks must be Filled

API # 15 - 063-21,078 - 00-00 (Identifier Number of this well). This must be listed for wells drilled since 1967; if no API # was issued, indicate original spud or completion date Drilled December 1986

Well Operator: Pickrell Drilling Company, Inc. KCC License #: 5123
(Owner / Company Name) (Operator's)

Address: 100 S. Main, Suite 505 City: Wichita

State: Kansas Zip Code: 67202 Contact Phone: (316) 262 - 8427

Lease: Brookover "C" Well #: 4 Sec. 22 Twp. 13 S. R. 30 East West
DPO New KCC 1-21-05 150' *New SE of E* NE Spot Location / QQQQ County: Gove

3850 Feet (in exact footage) From North / South (from nearest outside section corner) Line of Section (Not Lease Line)
1210 Feet (in exact footage) From East / West (from nearest outside section corner) Line of Section (Not Lease Line)

Check One: Oil Well Gas Well D&A Cathodic Water Supply Well
 SWD Docket # _____ ENHR Docket # _____ Other: _____

Conductor Casing Size: _____ Set at: _____ Cemented with: _____ Sacks

Surface Casing Size: 8 5/8 Set at: 350 Cemented with: 210 Sacks

Production Casing Size: 4 1/2 Set at: 4607 Cemented with: 550 Sacks

List (ALL) Perforations and Bridgeplug Sets: See attached sketch

RECEIVED
JAN 14 2005

Elevation: 2887/2892 (G.L. / K.B.) T.D.: 4619 P.B.T.D.: 4035 Anhydrite Depth: 2314 (+578) **KCC WICHITA**
KCC-1-18-05-SKA-Per log sheet. (Stone Corral Formation)

Condition of Well: Good Poor Casing Leak Junk in Hole

Proposed Method of Plugging (attach a separate page if additional space is needed): Use 60/40 Pox, 6% gel. Tie into 8 5/8 x 4 1/2 annulus and fill and leave SI w/ pressure. Down 4 1/2 pump 2 sx. hulls in water, pump 50 sx. cement w/ hulls in first four sacks, pump 20 bbls. of gel (6 sx.) mud, pump 145 sx. cement plus enough additional to pressure pipe. Leave SI w/ pressure.

Is Well Log attached to this application as required? Yes No Is ACO-1 filed? Yes No

If not explain why? Well log has been attached to previous application. Well is awaiting equipment availability and weather break to P&A.

Plugging of this Well will be done in accordance with K.S.A. 55-101 et. seq. and the Rules and Regulations of the State Corporation Commission.

List Name of Company Representative authorized to be in charge of plugging operations: Ed Mondero
Phone: (620) 793 - 2315

Address: P.O. Box 375 City / State: Ness City, Kansas 67560

Plugging Contractor: Allied Cementing Company, Inc. KCC License #: N/A
(Company Name) (Contractor's)

Address: H. Hwy 281, P.O. Box 628, Great Bend, Kansas 67530-0628 Phone: (620) 793 - 5861

Proposed Date and Hour of Plugging (if known?): January


Payment of the Plugging Fee (K.A.R. 82-3-118) will be guaranteed by Operator or Agent
Date: 01-13-05 Authorized Operator / Agent: Jack Gundry
(Signature)

Mail to: KCC - Conservation Division, 130 S. Market - Room 2078, Wichita, Kansas 67202

Company _____ Well No. 4 Field Lanice Lease Brookover "C"
 Company Man _____ Date Drilled Dec, 1986 County Gove State Kansas
 15-063-21078-00-00

Elev. : 2892 KB
2887 GL

E-Log Tops:
 Anhy.: 2314 (+578)
 Heeb.: 3872 (-980)
 Lsg.: 3910 (-1018)
 Stark: 4139 (-1247)
 BKC: 4211 (-1319)
 Miss: 4494 (-1602)

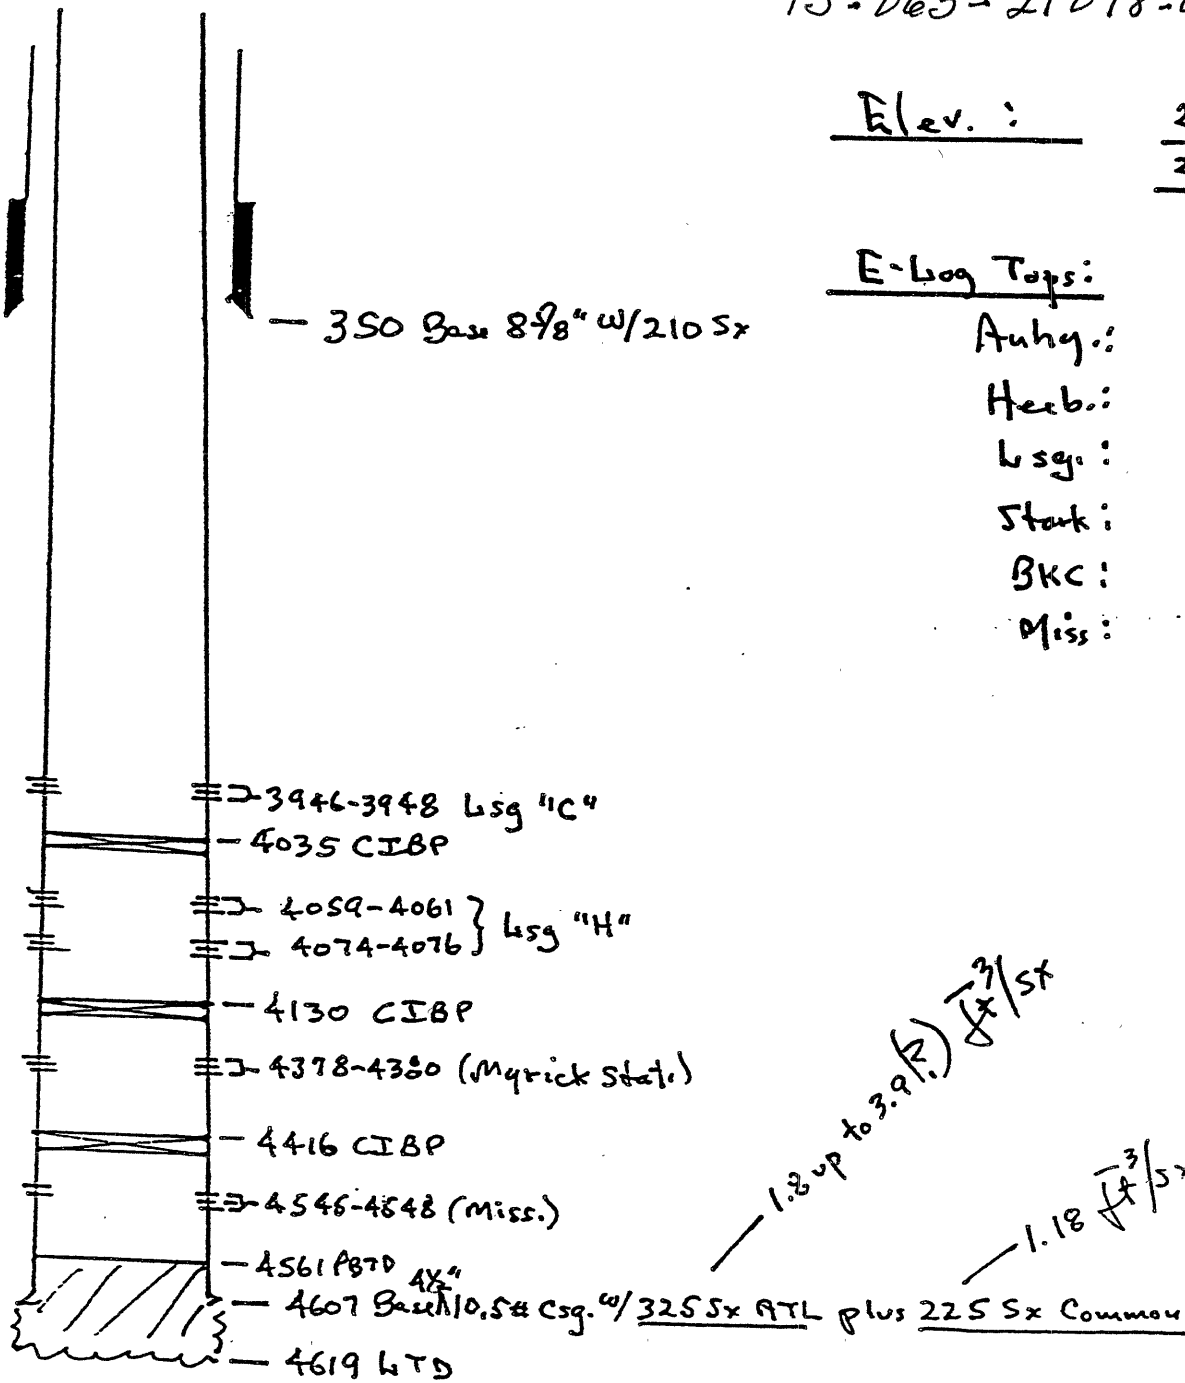

RECEIVED
 JAN 14 2005
 KCC WICHITA

REMARKS: _____

ATL Cement

65% Common	} 27 gal. wtr./sx 270# Compressive strength (7 days) Slurry Volume 3.9 ft ³ /sx (***) Wgt. 10.5-11.0 #/gal
35% Fly Ash	
10% Gel	
2% Soda Meta Activator	

(***) I now hear this could be 2.6 to 3.0 max

KANSAS

CORPORATION COMMISSION

Kathleen Sebelius, Governor Brian J. Moline, Chair Robert E. Krehbiel, Commissioner Michael C. Moffet, Commissioner

NOTICE OF RECEIPT OF WELL PLUGGING APPLICATION (CP-1)

Pickrell Drilling Company, Inc.
100 South Main - Suite 505
Wichita, KS 67202-3738

January 18, 2005

Re: BROOKOVER C #4
API 15-063-21078-00-00
NE 22-13S-30W, 3850 FSL 1210 FEL
GOVE COUNTY, KANSAS

Dear Operator:

This letter is to notify you that the Conservation Division is in receipt of your plugging proposal, form CP-1, for the above-captioned well.

Your CP-1 has been reviewed by the Conservation Division central office for completeness and to verify license numbers. The plugging proposal will now be forwarded to the district office listed below for review of your proposed method of plugging.


Please contact the district office for approval of your proposed plugging method at least five (5) days before plugging the well, pursuant to K.A.R. 82-3-113 (b). If a workover pit will be used during the plugging of the well it must be permitted. A CDP-1 form must be filed and approved prior to the use of the pit.

The Conservation Division's review of form CP-1, either in the central or district office, does not include an inquiry into well ownership or the filing operator's legal right to plug the well.

This notice in no way constitutes authorization to plug the above-captioned well by persons not having legal rights of ownership or interest in the well. This notice is void after ninety (90) days from the above date.

District: #4
2301 E. 13th
Hays, KS 67601
(785) 625-0550

Sincerely

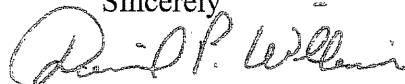

David P. Williams
Production Supervisor