

CARD MUST BE TYPED

State of Kansas

CARD MUST BE SIGNED

NOTICE OF INTENTION TO DRILL

(see rules on reverse side)

Starting Date 06 03 88
month day year

API Number 15-163-23,000 00-00

OPERATOR: License # 6926
Name Advantage Resources
Address 1775 Sherman, Suite 1345
City/State/Zip Denver, CO 80203

NW SW SE Sec. 29... Twp. 6S... S, Rg. 18W... East
990 West
2310 Ft. from South Line of Section
Ft. from East Line of Section

(Note: Locate well on Section Plat on reverse side)

Contact Person.....
Phone... 303-831-1912

Nearest lease or unit boundary line .. 330 feet
County..... Rooks.....

CONTRACTOR: License # 6033
Name Murfin Drilling Company
City/State... Wichita, KS

Lease Name... Ray Sanders..... Well #... 1.....
Ground surface elevation feet MSL

Well Drilled For: Well Class: Type Equipment:
 Oil _____ SWD _____ Infield _____ Mud Rotary
_____ Gas _____ Inj _____ Pool Ext. _____ Air Rotary
_____ OWWO _____ Expl _____ Wildcat _____ Cable

Domestic well within 330 feet: _____ yes no
Municipal well within one mile: _____ yes no

IF OWWO: old well info as follows:

Operator
Well Name
Comp Date Old Total Depth.....

Depth to bottom of fresh water..... 700
Depth to bottom of usable water 700 900

I certify that well will comply with K.S.A. 55-101, et seq., plus eventually plugging hole to KCC specifications.

Date ... 5-31-88 Signature of Operator or Agent

Surface pipe by Alternate: 1 _____ 2
Surface pipe planned to be set 200

For KCC Use:

Conductor Pipe Required feet; Minimum Surface Pipe Required

Conductor pipe required N/A
Projected Total Depth 3600 feet

This Authorization Expires 11-30-88

Formation..... Arbuckle
Drilling Manager

EFFECTIVE DATE: 6-5-88


Jack E. Goss, Agent for Operator Title
Approved By 2 CH 5-31-88 200 feet per Alt. X (2)

Must be filed with the K.C.C. five (5) days prior to commencing well
This card void if drilling not started within six (6) months of date received by K.C.C.

Important procedures to follow:

1. Notify District office before setting surface casing.
2. Set surface casing by circulating cement to the top.
3. File completion forms ACO-1 with K.C.C. within 90 days of well completion, following instructions on ACO-1, side 1, and including copies of wireline logs.
4. Notify District office 48 hours prior to old well workover or re-entry.
5. Prior to filing Intent, prepare a proposed plugging plan in case well is D & A, then obtain approval of plan when calling district office prior to setting surface pipe.
6. Submit plugging report (CP-4) to K.C.C. after plugging is completed.
7. Obtain an approved injection docket number before disposing of salt water.
8. Notify K.C.C. within 10 days when injection commences or terminates.
9. If an alternate 2 completion, cement in the production pipe from below any usable water to surface within 120 days of spud date.

A Regular Section of Land
1 Mile = 5,280 Ft.

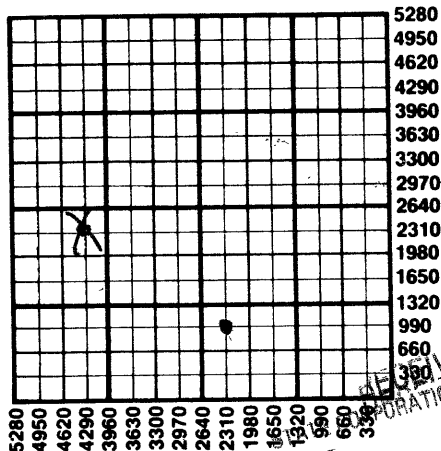

RECEIVED
MAY 31 1988

CONSERVATION DIVISION
Wichita, Kansas

5-31-88

State Corporation Commission of Kansas
Conservation Division
200 Colorado Derby Building
Wichita, Kansas 67202
(316) 263-3238