

CARD MUST BE TYPED

State of Kansas
NOTICE OF INTENTION TO DRILL
(see rules on reverse side)

CARD MUST BE SIGNED

Starting Date: MAY 6 1985
month day year

API Number 15- 163-21,907-0001

OPERATOR: License # 7562
Name AMES ENERGY EXPLORATION
Address P.O. BOX 1309
City/State/Zip HAYS, KS 67601
Contact Person Edith Ward
Phone (913)628-2289

SE. NW. SE. . . . Sec 8. 2. Twp 6. . . . S, Rge 20. . . . East
(location) West

.1650! Ft North from Southeast Corner of Section
.1650! Ft West from Southeast Corner of Section
(Note: Locate well on Section Plat on reverse side)

CONTRACTOR: License # 6176
Name IVAN HOLT WELL SERVICING, INC.
City/State RUSSELL, KS 67665

Nearest lease or unit boundary line 330! feet.
County ROOKS
Lease Name HAMIT Well# 1

Well Drilled For: Well Class: Type Equipment:
 Oil Swd Infield Mud Rotary
 Gas Inj Pool Ext. Air Rotary
 OWWO Expl Wildcat Cable

Domestic well within 330 feet: yes no
Municipal well within one mile: yes no

Depth to Bottom of fresh water 100! feet
Lowest usable water formation DAKOTA
Depth to Bottom of usable water 500! 1000 feet
Surface pipe by Alternate: 1 2
Surface pipe ~~set~~ set 272! feet
Conductor pipe if any required 0 feet
Ground surface elevation 2133! feet MSL
This Authorization Expires 11-1-85
Approved By 5-1-85

If OWWO: old well info as follows:

Operator CINCO, INC.
Well Name HAMIT #1
Comp Date 12-10-82 Old Total Depth 3618!
Projected Total Depth XXXX! 3580! feet
Projected Formation at TD Reagan Sand
Expected Producing Formations Reagan Sand, KC

I certify that we will comply with K.S.A. 55-101, et seq., plus eventually plugging hole to K.C.C. specifications.

Date 4-30-85 Signature of Operator or Agent

Steven A. Ward Title *Agent*


Form C-1 4/84

MHC 1404E 5-1-85

**Must be filed with the K.C.C. five (5) days prior to commencing well
This card void if drilling not started within six (6) months of date received by K.C.C.**

Important procedures to follow :

**A Regular Section of Land
1 Mile = 5,280 Ft.**

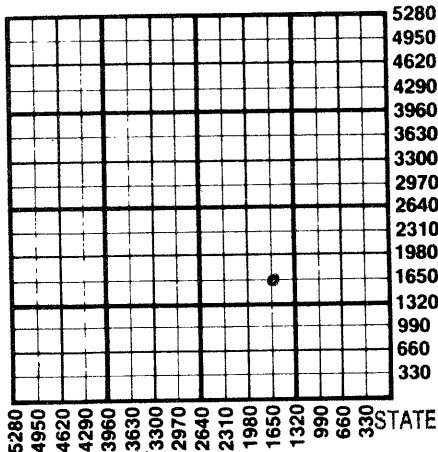

1. Notify District office before setting surface casing.
2. Set surface casing by circulating cement to the top.
3. File completion forms ACO-1 with K.C.C. within 90 days of well completion, following instructions on ACO-1, side 1, and including copies of wireline logs.
4. Notify District office 48 hours prior to old well workover or re-entry.
5. Prior to plugging, prepare a plugging plan, then obtain agreement from the appropriate district office for an approved plugging plan.
6. Submit plugging report (CP-4) to K.C.C. after plugging is completed.
7. Obtain an approved injection docket number before disposing of salt water.
8. Notify K.C.C. within 10 days when injection commences or terminates.
9. If an alternate 2 completion, cement in the production pipe from below usable water to surface within 120 days of spud date.

RECEIVED

STATE CORPORATION COMMISSION

**State Corporation Commission of Kansas
Conservation Division
200 Colorado Derby Building
Wichita, Kansas 67202
(316) 263-3238**

MAY 01 1985
S-186
**CONSERVATION DIVISION
Wichita, Kansas**