

CARD MUST BE TYPED

State of Kansas

CARD MUST BE SIGNED

# NOTICE OF INTENTION TO DRILL

(see rules on reverse side)

Starting Date .. December 6, 1985  
month day year

API Number 15— 163,21,492 - 00-01

OPERATOR: License # 7562

C W/2 SE SW Sec. 2 Twp. 6 S, Rg. 20 XX East  
990 West  
3630 Ft. from South Line of Section  
Ft. from East Line of Section

Name .. Ames ~~Oil & Gas~~ Energy Eval

Address .. Box 1309

City/State/Zip .. Hays, Kansas 67601

Contact Person... Steve Ward

Phone .. 913.628.2289

(Note: Locate well on Section Plat on reverse side)

CONTRACTOR: License # 6176

Nearest lease or unit boundary line .. 990 feet

County .. Rooks

Name .. Ivan Holt Well Servicing, Inc.

Lease Name .. Nichol Well # 1 SWD

City/State .. Box 671, Russell, Kansas 67655

Ground surface elevation .. 2118 feet MSL

Well Drilled For: Well Class: Type Equipment:

Domestic well within 330 feet:  yes  no

Oil  SWD  Infield  Mud Rotary

Municipal well within one mile:  yes  no

Gas  Inj  Pool Ext.  Air Rotary

Surface pipe by Alternate:

OWWO  Expl  Wildcat  Cable

Depth to bottom of fresh water .. 200

If OWWO: old well info as follows:

Depth to bottom of usable water .. ~~600~~ 1000

Operator .. W. E. Carl & Associates Petr. Cons.

Surface pipe planned to be set .. 609 in hole

Well Name .. #2 "B" Nichol

Projected Total Depth .. 1700 feet

Comp Date .. 12-13-81 Old Total Depth .. 3625

Formation .. Cedar Hill

I certify that well will comply with K.S.A. 55-101, et seq., plus eventually plugging hole to KCC specifications.

*PCA/PAE*

~~\_\_\_\_\_~~ cementing will be done immediately upon setting production casing.

Date .. 12/3/85 Signature of Operator or Agent *Clarice Barlow* Title .. as agent

For KCC Use:

Conductor Pipe Required .. feet; Minimum Surface Pipe Required .. feet per 1 2

This Authorization Expires .. 6-3-86 Approved By .. 12-3-85

RECEIVED  
STATE CORPORATION COMMISSION

Must be filed with the K.C.C. five (5) days prior to commencing well

This card void if drilling not started within six (6) months of date received by K.C.C.

DEC 03 1985


CONSERVATION DIVISION

Wichita, Kansas

12-3-85

**A Regular Section of Land**

**1 Mile = 5,280 Ft.**

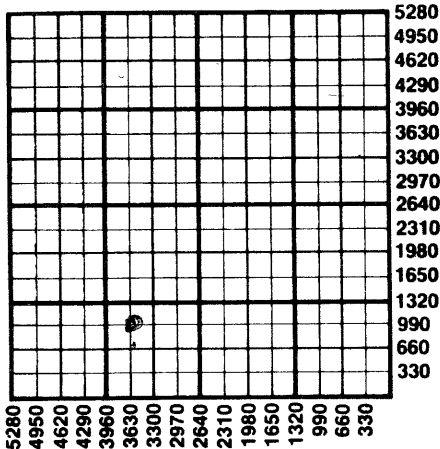

**Important procedures to follow:**

1. Notify District office before setting surface casing.
2. Set surface casing by circulating cement to the top.
3. File completion forms ACO-1 with K.C.C. within 90 days of well completion, following instructions on ACO-1, side 1, and including copies of wireline logs.
4. Notify District office 48 hours prior to old well workover or re-entry.
5. Prior to filing Intent, prepare a proposed plugging plan in case well is D & A, then obtain approval of plan when calling district office prior to setting surface pipe.
6. Submit plugging report (CP-4) to K.C.C. after plugging is completed.
7. Obtain an approved injection docket number before disposing of salt water.
8. Notify K.C.C. within 10 days when injection commences or terminates.
9. If an alternate 2 completion, cement in the production pipe from below any usable water to surface within 120 days of spud date.

State Corporation Commission of Kansas

Conservation Division

200 Colorado Derby Building

Wichita, Kansas 67202

(316) 263-3238