


15-163-00994-00-00

STATE OF KANSAS
STATE CORPORATION COMMISSION

Give All Information Completely
Make Required Affidavit
Mail or Deliver Report to:
Conservation Division
State Corporation Commission
211 No. Broadway
Wichita, Kansas

WELL PLUGGING RECORD

NORTH

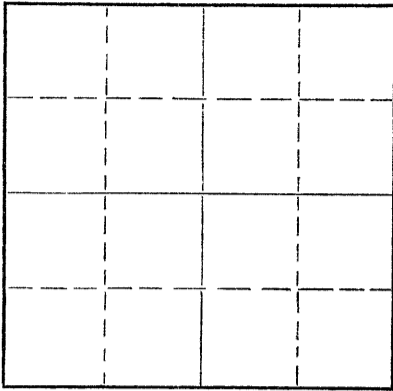

Locate well correctly on above
Section Plat

Rooks County. Sec. 3 Twp. 6 S Rge. 18 (X) (W)
Location as "NE/CNW%SW%" or footage from lines NW SW SW
Lease Owner Ware Watson
Lease Name MILIER Well No. 1
Office Address 620 Elm Ave., Janebora, Ark.
Character of Well (completed as Oil, Gas or Dry Hole) Dry
Date well completed 10/25/56 19
Application for plugging filed 10/24/56 19
Application for plugging approved 10/24/56 19
Plugging commenced 10/25/56 19
Plugging completed 10/25/56 19
Reason for abandonment of well or producing formation Dry

If a producing well is abandoned, date of last production _____ 19
Was permission obtained from the Conservation Division or its agents before plugging was commenced? yes

Name of Conservation Agent who supervised plugging of this well Eldon Petty
Producing formation _____ Depth to top _____ Bottom _____ Total Depth of Well 3475 Feet
Show depth and thickness of all water, oil and gas formations.

OIL, GAS OR WATER RECORDS

CASING RECORD

FORMATION	CONTENT	FROM	TO	SIZE	PUT IN	PULLED OUT
				13 3/8	132'	none

Describe in detail the manner in which the well was plugged, indicating where the mud fluid was placed and the method or methods used in introducing it into the hole. If cement or other plugs were used, state the character of same and depth placed, from _____ feet to _____ feet for each plug set.

PLUGGING RECORD

Plugged 3475 up to 125' with heavy rotary mud. At 125' used 1/2 sack hulls, set wood plug, with 35 sacks cement through drill pipe up to 105'. Top left open to be used for water well by Landowner. Okeyed by State Pluggger, Mr. Petty.

(If additional description is necessary, use BACK of this sheet)

Name of Plugging Contractor Sierra Petroleum Co., Inc.
Address 420 W. Douglas Ave., Wichita, Kansas

STATE OF KANSAS, COUNTY OF RUSSELL, ss.
C. T. Honaker (employee of owner) or (owner or operator) of the above-described well, being first duly sworn on oath, says: That I have knowledge of the facts, statements, and matters herein contained and the log of the above-described well as filed and that the same are true and correct. So help me God.

(Signature) C. T. Honaker

(Address) _____

SUBSCRIBED AND SWORN TO before me this 26th day of October, 19 56

My commission expires 1-30-57

Margie Cooper
Notary Public.
Wichita, Kansas
10-27-56

PLUGGING
FILE SEC 3 T. 6 R. 18W
BOOK PAGE 110 LINE 44