

15-163-30134-00-00

STATE OF KANSAS
STATE CORPORATION COMMISSION


Form CP-4

Give All Information Completely
Make Required Affidavit
Mail or Deliver Report to:
Conservation Division
State Corporation Commission
212 No. Market
Wichita, Kansas

WELL PLUGGING RECORD

Rooks County, Sec. 1 Twp. 6S Rge. (E) 18 (W)

Location as "NE/CNW%SW%" or footage from lines NW/4 SE/4 SW/4
Lease Owner Forrest H. Lindsay - National Associated Petroleum
Lease Name W. L. Faubion Well No. 1
Office Address Fifth Floor, Ritz Building, Tulsa, Oklahoma
Character of Well (completed as Oil, Gas or Dry Hole) Dry Hole
Date well completed February 25 1966
Application for plugging filed February 25 (Verbal) 1966
Application for plugging approved February 25 (Verbal) 1966
Plugging commenced February 25 1966
Plugging completed February 25 1966
Reason for abandonment of well or producing formation Dry Hole

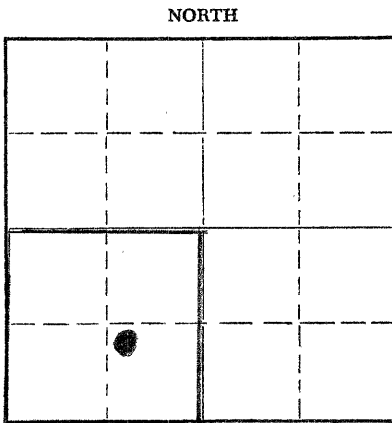

Locate well correctly on above
Section Plat

If a producing well is abandoned, date of last production _____ 19____
Was permission obtained from the Conservation Division or its agents before plugging was commenced? Yes

Name of Conservation Agent who supervised plugging of this well _____
Producing formation _____ Depth to top _____ Bottom _____ Total Depth of Well 3442 Feet
Show depth and thickness of all water, oil and gas formations.

OIL, GAS OR WATER RECORDS

CASING RECORD

FORMATION	CONTENT	FROM	TO	SIZE	PUT IN	PULLED OUT

Describe in detail the manner in which the well was plugged, indicating where the mud fluid was placed and the method or methods used in introducing it into the hole. If cement or other plugs were used, state the character of same and depth placed, from _____ feet to _____ feet for each plug set.

Mud to 540' - Plug W 25 sacks cement
Mud to 250' - 1/2 sack hulls- plug and
25 sacks cement - mud to 40', 10 sacks
cement to 5' - 5 sacks cement in rathole

RECEIVED
STATE CORPORATION COMMISSION

APR 13 1966

4-13-66

CONSERVATION DIVISION
WICHITA, KANSAS

(If additional description is necessary, use BACK of this sheet)

Name of Plugging Contractor Thoroughbred Drilling Company
Address 517 Ritz Building, Tulsa, Oklahoma

STATE OF OKLAHOMA, COUNTY OF TULSA, ss.

Dan W. Brown - Thoroughbred Drilling Company (employee of owner) or (owner or operator) of the above-described well, being first duly sworn on oath, says: That I have knowledge of the facts, statements, and matters herein contained and the log of the above-described well as filed and that the same are true and correct. So help me God.

(Signature) Dan W. Brown

517 Ritz Building, Tulsa, Oklahoma

(Address)

SUBSCRIBED AND SWORN TO before me this 11th day of April, 19 66

Maxine D. Provine
Maxine D. Provine Notary Public.

My commission expires February 21, 1969