

15-163-00235-0600


STATE OF KANSAS
STATE CORPORATION COMMISSION

WELL PLUGGING RECORD

Give All Information Completely
Make Required Affidavit
Mail or Deliver Report to:
Conservation Division
State Corporation Commission
800 Biting Building
Wichita, Kansas

OR
FORMATION PLUGGING RECORD Strike out upper line when reporting plugging of formations.

Rooks County. Sec. 1 Twp. 6 Rge. (E) 18 (W)
Location as "NE $\frac{1}{4}$ NW $\frac{1}{4}$ SW $\frac{1}{4}$ " or footage from lines. NW NW NW
Lease Owner G. L. Reasor
Lease Name Howe Well No. 1
Office Address 135 S. LaSalle St. Chicago, Ill.
Character of Well (completed as Oil, Gas or Dry Hole) Dry Hole
Date well completed May 9, 1949 19
Application for plugging filed May 9, 1949 (telephone) 19
Application for plugging approved May 9, 1949 (telephone) 19
Plugging commenced May 9, 1949 4:00 P.M. 19
Plugging completed May 9, 1949 6:00 P.M. 19
Reason for abandonment of well or producing formation
Dry Hole
If a producing well is abandoned, date of last production 19
Was permission obtained from the Conservation Division or its agents before plugging was commenced? Yes

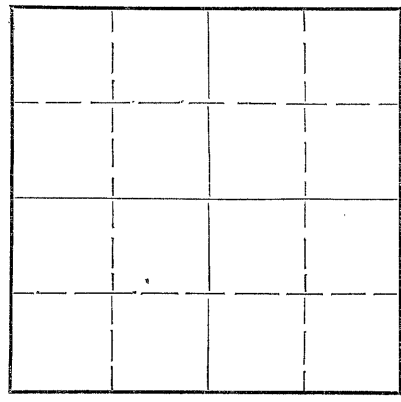

Locate well correctly on above Section Plat

Name of Conservation Agent who supervised plugging of this well Mr. C. D. Stough
Producing formation None Depth to top Bottom Total Depth of Well 3450 Feet
Show depth and thickness of all water, oil and gas formations.

OIL, GAS OR WATER RECORDS

CASING RECORD

Formation	Content	From	To	Size	Put In	Pulled Out
Water Sand		0	110	8-5/8"	300'	None

Describe in detail the manner in which the well was plugged, indicating where the mud fluid was placed and the method or methods used in introducing it into the hole. If cement or other plugs were used, state the character of same and depth placed, from 0 feet to 300' feet for each plug set.

Heavy Mud from 3450' to 300'-Plug and 15 sacks cement at 300'. Heavy mud from plug at 300' to 30'-Plug and 10 sacks cement at 30' filling surface pipe to surface.

RECEIVED

Conservation Div.

(If additional description is necessary, use BACK of this sheet)

Correspondence regarding this well should be addressed to G. L. Reasor JUN - 2 1949
Address 135 S. LaSalle Street, Chicago, Illinois 6-2-49

STATE CORPORATION COMMISSION KANSAS


STATE OF Illinois COUNTY OF Cook
G. L. Reasor (employee of owner) or (owner or operator) of the above-described well,

being first duly sworn on oath, says: That I have knowledge of the facts, statements, and matters herein contained and the log of the above-described well as filed and that the same are true and correct. So help me God.

(Signature) S. L. Reasor
135 S. La Salle St., Chicago, Ill.
(Address)

SUBSCRIBED AND SWORN to before me this 27 day of May 1949
Harvey J. O'Connell Notary Public.

My commission expires Jan 2 -

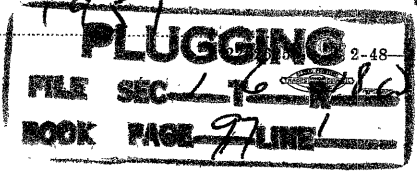

Howe Well No. 1

NW NW NW
Sec. 1-6-18
Rooks County, Kansas

Log

Clay, sand	0- 110	
Shale	110- 300	8-5/8" w/ 250 sx. @ 300'
Cement	290- 300	
Sand, shale	300-1220	
Shale, shells	1220-1315	
Anhydrite	1315-1353	
Shale, shells	1353-1825	
Shale	1825-2040	
Shale, shells	2040-2060	
Shale, lime	2060-3050	
Lime	3050-3380	
Conglomerate & lime	3380-3430	
Lime	3430-3450	TD D & A

State of Kansas)
County of Sedgwick)ss

I, E. H. Sloyer, do hereby certify that the above is a true and accurate log of the Howe Well No. 1 in the NW/4 of the NW/4 of the NW/4 of Section 1-6-18, Rooks County, Kansas.

E. H. Sloyer
Secretary

Sworn to and subscribed before me this 14th day of May, 1949.

R. M. Green
Notary Public

My commission expires December 29, 1952.

RECEIVED
Conservation Div.
JUL 14 1949
STATE CORPORATION
COMMISSION
KANSAS

7-14-49

PLUGGING
FILE SEC 1 T 6 18
BOOK PAGE 97 LINE 1