


15-163-00683-00-00

STATE OF KANSAS
STATE CORPORATION COMMISSION

Give All Information Completely
Make Required Affidavit
Mail or Deliver Report to:
Conservation Division
State Corporation Commission
800 Biting Building
Wichita, Kansas

WELL PLUGGING RECORD

Rooks County. Sec. 14 Twp. 6S Rge. (E) 18 (W)
Location as "NE/CNW/SW" or footage from lines NW/4 SE/4 SW/4
Lease Owner Morrison Drilling Company, Inc.
Lease Name N. H. Home Well No. 1
Office Address Drawer 712, El Dorado, Kansas
Character of Well (completed as Oil, Gas or Dry Hole) Dry Hole
Date well completed April 9 19 54
Application for plugging filed Verbal April 9 19 54
Application for plugging approved Verbal April 9 19 54
Plugging commenced April 9 19 54
Plugging completed April 9 19 54
Reason for abandonment of well or producing formation

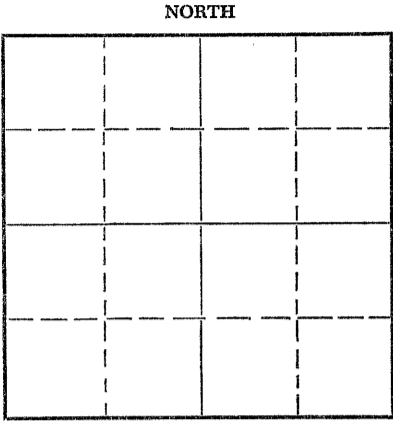

Locate well correctly on above
Section Plat

If a producing well is abandoned, date of last production 19
Was permission obtained from the Conservation Division or its agents before plugging was commenced? Yes

Name of Conservation Agent who supervised plugging of this well Eldon Petty
Producing formation Depth to top Bottom Total Depth of Well 3575' Feet
Show depth and thickness of all water, oil and gas formations.

OIL, GAS OR WATER RECORDS

CASING RECORD

FORMATION	CONTENT	FROM	TO	SIZE	PUT IN	PULLED OUT

Describe in detail the manner in which the well was plugged, indicating where the mud fluid was placed and the method or methods used in introducing it into the hole. If cement or other plugs were used, state the character of same and depth placed, from feet to feet for each plug set.

Lowered Suction; circulated 30 minutes to get heavy mud down hole. Set bottom plug at 300 ft. 1/3 sack of hulls cemented w/15 sacks of mixed cement. Filled hole on up to length of Kelly-Pushed plug down w/Kelly. Another 1/3 sack of hulls cemented w/10 sacks of cement - cement cap.

(If additional description is necessary, use BACK of this sheet)

Name of Plugging Contractor Morrison Drilling Company, Inc.
Address Drawer 712, El Dorado, Kansas

STATE OF Kansas, COUNTY OF Butler, ss.
C. W. Wilson (employee of owner) of the above-described well, being first duly sworn on oath, says: That I have knowledge of the facts, statements, and matters herein contained and the log of the above-described well as filed and that the same are true and correct. So help me God.

(Signature) [Signature]
Drawer 712, El Dorado, Kansas (Address)

SUBSCRIBED AND SWORN TO before me this 12th day of April, 19 54.

My commission expires January 10, 1955.

24-7366-S 3-53-20M

PLUGGING
FILE REC 14 T 6 180
BOOK PAGE 26 LINE 27

RECEIVED
STATE CORPORATION COMMISSION
APR 14 1954
CONSERVATION DIVISION
Wichita, Kansas

4-14-54

Notary Public.

15-163-00683-00-00

WELL LOG - N. H. HOME #1

OPERATOR: Morrison Drilling Company, Inc.
Drawer 712
El Dorado, Kansas

LOCATION: NW/4 SE/4 SW/4
Section 14-6S-18W
Rooks County, Kansas

CONTRACTOR: Morrison Drilling Company, Inc.
Drawer 712
El Dorado, Kansas

PRODUCTION: D & A

Farm: N. H. Home #1
Date Commenced: March 22, 1954
Date Completed: April 9, 1954

Total Depth: 3575' - Rotary

<u>From</u>	<u>To</u>	<u>Formation</u>
0	40	Surface soil and clay
40	120	Shale
120	329	Shale and lime shells
329	985	Shale and shells
985	1145	Sand
1145	1455	Shale and red bed streaks
1455	1510	Lime (Anhydrite)
1510	1750	Shale and shells
1750	2080	Shale and lime streaks
2080	2180	Lime and shale
2180	2258	Shale and lime streaks
2258	2350	Lime and shale
2350	2495	Lime and shale streaks
2495	2950	Lime and shale
2950	3025	Lime - Topeka
3025	3110	Lime
3110	3160	Lime and shale
3160	3202	Shale and lime
3202	3215	Lime - Kansas City
3215	3403	Lime
3403	3525	Lime and shale
3525	3562	Shale and lime
3562	3575	Lime
3575		Total Depth'

I hereby certify that the foregoing is a true and correct copy of the Well Log for the N. H. Home #1 well drilled for Morrison Drilling Company, Inc. and completed April 9, 1954.

MORRISON DRILLING COMPANY, INC.

C. W. Wilson - Secretary Treasurer

STATE OF KANSAS)
) ss:
COUNTY OF BUTLER)

SUBSCRIBED AND SWORN TO, Before the Undersigned, a Notary Public, in and for the County and State aforesaid this 12th day of April, 1954.

Notary Public

My Commission Expires January 10, 1955.

PLUGGING
FILE NO. 1476-186
BOOK PAGE 26 LINE 22

RECEIVED
STATE COMMISSION OF CONSERVATION
APR 14 1954
CONSERVATION DIVISION
Wichita, Kansas
4-14-54