

15-163-30157-00-00

Give All Information Completely  
Make Required Affidavit  
Mail or Deliver Report to:  
Conservation Division  
State Corporation Commission  
212 No. Market  
Wichita, Kansas

WELL PLUGGING RECORD

Rooks County, Sec. 13 Twp. 6S Rge. (E) 18(W)

Location as "NE/CNW $\frac{1}{4}$ SW $\frac{1}{4}$ " or footage from lines SE/4 SE/4 SW/4

Lease Owner Forrest H. Lindsay - National Associated Petroleum

Lease Name M. F. Bartholomew Well No. 1

Office Address Fifth Floor, Ritz Building, Tulsa, Oklahoma

Character of Well (completed as Oil, Gas or Dry Hole) Dry Hole

Date well completed February 14 19 66

Application for plugging filed February 14 19 66

Application for plugging approved February 14 (Verbal) 19 66


Plugging commenced February 14 19 66

Plugging completed February 14 19 66

Reason for abandonment of well or producing formation Dry Hole

If a producing well is abandoned, date of last production \_\_\_\_\_ 19 \_\_\_\_\_

Was permission obtained from the Conservation Division or its agents before plugging was commenced? Yes

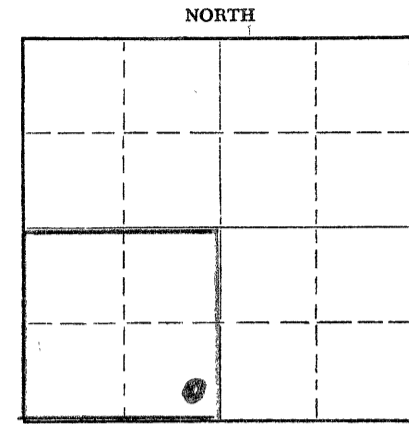

Locate well correctly on above Section Plat

Name of Conservation Agent who supervised plugging of this well Gilbert Leiker

Producing formation \_\_\_\_\_ Depth to top \_\_\_\_\_ Bottom \_\_\_\_\_ Total Depth of Well 3613 Feet

Show depth and thickness of all water, oil and gas formations.

OIL, GAS OR WATER RECORDS

CASING RECORD

FORMATION	CONTENT	FROM	TO	SIZE	PUT IN	PULLED OUT

Describe in detail the manner in which the well was plugged, indicating where the mud fluid was placed and the method or methods used in introducing it into the hole. If cement or other plugs were used, state the character of same and depth placed, from \_\_\_\_\_ feet to \_\_\_\_\_ feet for each plug set.

200 sacks cement - cement 540' - mud up to 200'  
1/2 sack hulls - plug with 25 sacks cement  
Mud to 40' - 1/2 sack hulls, 100 sacks cement to 5'  
5 sacks cement in rathole

RECEIVED  
STATE CORPORATION COMMISSION  
APR 13 1966  
4-13-66  
CONSERVATION DIVISION  
Wichita, Kansas

(If additional description is necessary, use BACK of this sheet)

Name of Plugging Contractor Thoroughbred Drilling Company  
Address 517 Ritz Building, Tulsa, Oklahoma

STATE OF OKLAHOMA, COUNTY OF TULSA, ss.

Dan W. Brown, Thoroughbred Drilling Company (employee of owner) or (owner or operator) of the above-described well, being first duly sworn on oath, says: That I have knowledge of the facts, statements, and matters herein contained and the log of the above-described well as filed and that the same are true and correct. So help me God.

(Signature) Dan W. Brown  
517 Ritz Building, Tulsa, Oklahoma  
(Address)

SUBSCRIBED AND SWORN TO before me this 11th day of April, 19 66

My commission expires February 21, 1969  
Maxine D. Provine Notary Public.