

15-163-21061-00-00


STATE OF KANSAS
STATE CORPORATION COMMISSION

WELL PLUGGING RECORD

Give All Information Completely
Make Required Affidavit
Mail or Deliver Report to
Conservation Division
State Corporation Comm.
245 North Water
Wichita, KS 67202

Rooks County. Sec. 16 Twp. 6 Rge. 18 E/W
Location as "NE/CNW $\frac{1}{4}$ SW $\frac{1}{4}$ " or footage from lines
NE NE SW

Lease Owner Robert R. Price
Lease Name McQueen Well No. 1
Office Address Box 455442 Tulsa, Ok 74145
Character of Well (Completed as Oil, Gas or Dry Hole)
dry hole

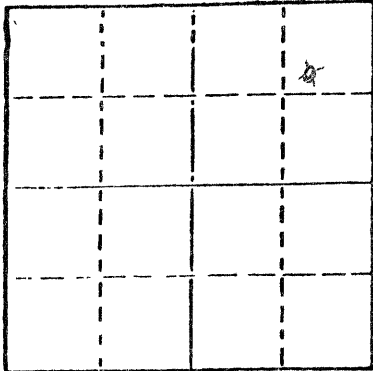

Locate well correctly on above
Section Plat

Date Well completed 4-26 1980
Application for plugging filed 4-26 1980
Application for plugging approved 4-26 1980
Plugging commenced 4-26 1980
Plugging completed 4-26 1980

Reason for abandonment of well or producing formation
dry hole

If a producing well is abandoned, date of last production
19

Was permission obtained from the Conservation Division or
its agents before plugging was commenced? yes

Name of Conservation Agent who supervised plugging of this well Marion Schmidt
Producing formation Depth to top Bottom Total Depth of Well 3541
Show depth and thickness of all water, oil and gas formations.

OIL, GAS OR WATER RECORDS

CASING RECORD

FORMATION	CONTENT	FROM	TO	SIZE	PUT IN	PULLED OUT
Surface		0	211	8 5/8"	211	0

Describe in detail the manner in which the well was plugged, indicating where the mud fluid was placed and the method or methods used in introducing it into the hold. If cement or other plugs were used, state the character of same and depth placed, from feet to feet for each plug set.

- 1st Plug set at 775' with 70 sacks cement 50-50 poz 6% gel
- 2nd Plug set at 210' with 20 sacks cement 50-50 poz 6% gel
- 3rd Plug set at 40' with 10 sacks cement 50-50 poz 6% gel
- 5 sacks in rathole

(If additional description is necessary, use BACK of this sheet) 6-3-80

Name of Plugging Contractor Sun Oilwell Cementing


STATE OF Kansas COUNTY OF Graham, ss.
Jerry M. Helberg (employee of owner) or (owner or operator)
of the above-described well, being first duly sworn on oath, says: That I have knowledge of the facts, statements, and matters herein contained and the log of the above-described well as filed and that the same are true and correct. So help me God.

(Signature)

Jerry M. Helberg
Box 32 Morland, Kansas 67650
(Address)

SUBSCRIBED AND SWORN TO before me this 19th day of May, 1980

My commission expires

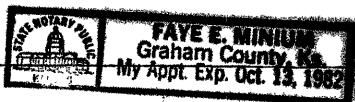

Faye E. Minium
Notary Public.

15-163-21061-00-00

DRILLERS LOG

MC QUEEN #1

CASING RECORD:

8 5/8" set at 211'

TOTAL DEPTH:

3541'

DESCRIPTION:

NE NE SW
Sec. 16-6-18 Rooks County, Kansas

OPERATOR: Robert R. Price

CONTRACTOR: Helberg Oil Company

COMMENCED: April 18, 1980

COMPLETED: April 26, 1980

FORMATION	FROM	TO	REMARKS
Shale	0	227	
Sand & Shale	227	472	
Sand & Shale	472	1390	
Shale	1390	1432	
Anhydrite	1432	1462	
Shale	1462	1642	
Shale & Lime	1642	1940	
Lime & Shale	1940	2133	
Lime & Shale	2133	2264	
Shale & Lime	2264	2411	
Lime & Shale	2411	2527	
Lime & Shale	2527	2658	
Shale & Lime	2658	2799	
Lime & Shale	2799	2920	
Lime & Shale	2920	2957	
Lime & Shale	2957	3019	
Lime & Shale	3019	3097	
Lime & Shale	3097	3165	
Lime & Shale	3165	3240	
Lime	3240	3276	
Lime	3276	3328	
Lime	3328	3400	
Lime	3400	3440	
Lime	3355	3440	
Lime	3440	3502	
Lime & Shale	3502	3541	
T.D.	3541		D & A

STATE RECEIVED
 STATE COMMISSION
 JUN 11 1980
 CONSERVATION DIVISION
 WICHITA, KANSAS
 63-80

I certify that the above is a true and correct copy of the log to the best of my knowledge.

HELBERG OIL COMPANY

Jerry M. Helberg
 Jerry M. Helberg

Subscribed and sworn to before me this 19th day of May, 1980.

James E. Morrison
 Notary Public

My commission expires

