


15-163-20825-00-00

STATE OF KANSAS
STATE CORPORATION COMMISSION

WELL PLUGGING RECORD

Give All Information Completely
Make Required Affidavit
Mail or Deliver Report to
Conservation Division
State Corporation Comm.
245 North Water
Wichita, KS 67202

Rooks County. Sec. 2 Twp. 6 Rge. 20 E/W
Location as "NE/CNW $\frac{1}{4}$ SW $\frac{1}{4}$ " or footage from lines
SE SW SE
Lease Owner Brandt Oil Co.
Lease Name Hanson Estate #1 Well No.
Office Address Wichita, Kansas 67202
Character of Well (Completed as Oil, Gas or Dry Hole)

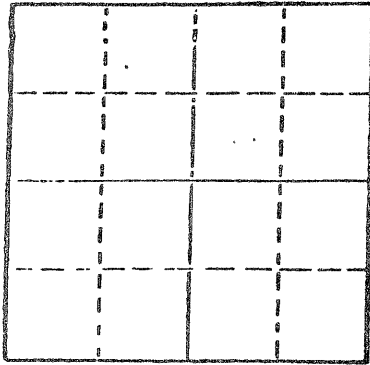

Locate well correctly on above
Section Plot

Date Well completed 19
Application for plugging filed 19
Application for plugging approved 19
Plugging commenced 8/10/79 19
Plugging completed 8/15/79 19
Reason for abandonment of well or producing formation
depleted.
If a producing well is abandoned, date of last production 19

Was permission obtained from the Conservation Division or
its agents before plugging was commenced? yes
Schmidt

Name of Conservation Agent who supervised plugging of this well
Producing formation Depth to top Bottom Total Depth of Well 3585
Show depth and thickness of all water, oil and gas formations.

OIL, GAS OR WATER RECORDS

CASING RECORD

FORMATION	CONTENT	FROM	TO	SIZE	PUT IN	PULLED OUT
				8-5/8	241	none
				4 1/2"	3582	2034

Describe in detail the manner in which the well was plugged, indicating where the mud fluid
was placed and the method or methods used in introducing it into the hold. If cement or other
plugs were used, state the character of same and depth placed, from feet to
feet for each plug set.

Pumped 35 sacks cement, pushed plug to 3300'. Shot pipe at 2504', 2215', 2021',
pulled 63 joints. Pumped 4 sacks hulls, 18 sacks gel and 135 sacks 50-50 pos, 6%,
8-5/8 plug.

PLUGGING COMPLETE.

(If additional description is necessary, use BACK of this sheet)

Name of Plugging Contractor KESLO CASING PULLING
CHASE, KANSAS


STATE OF KANSAS COUNTY OF RICE, ss.
R. DARRELL KELSO (employee of owner) or (owner or operator)
of the above-described well, being first duly sworn on oath, says: That I have knowledge of
the facts, statements, and matters herein contained and the log of the above-described well
as filed and that the same are true and correct. So help me God.

(Signature) R. Darrell Kelso
CHASE, KANSAS

SUBSCRIBED AND SWORN TO before me this 24th. day of August, 19 79

Margaret Melcher
Notary Public.

My commission expires

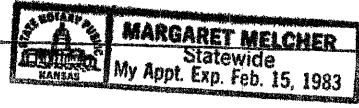

RECEIVED
STATE CORPORATION COMMISSION
8-27-79
AUG 27 1979

CONSERVATION DIVISION
Wichita, Kansas