

NOTICE OF INTENT TO DRILL

Must be approved by KCC five (5) days prior to commencing well

For KCC Use:

Effective Date: 2.14.05

District # _____

SGA? Yes No

Expected Spud Date MAY 10 2005
month day year

OPERATOR: License # 04824
Name: PIONEER NATURAL RESOURCES USA, INC.
Address: 5205 N. O'CONNOR BLVD. - ROOM 1325
City/State/Zip: IRVING, TEXAS 75039
Contact Person: LINDA KELLY
Phone: 972-969-3946

CONTRACTOR: License #: WILL ADVISE ON ACO-1
Name: MUST BE LICENSED W/ KCC

Well Drilled For: Oil Enh Rec Infield Mud Rotary
 Gas Storage Pool Ext. Air Rotary
 OWWO Disposal Wildcat Cable
 Seismic; _____ # of Holes Other
 Other REPLACEMENT

If OWWO: old well information as follows:
Operator: _____
Well Name: _____
Original Completion Date: _____ Original Total Depth _____

Directional, Deviated or Horizontal wellbore? Yes No

If yes, true vertical depth: _____

Bottom Hole Location _____

KCC DKT # _____

Spot NE NE/4 SW/4 SW/4 Sec 6 Twp 30 S. R. 35 East West

1250 feet from N / S Line of Section

1250 feet from E / W Line of Section

Is SECTION X Regular Irregular?

(Note: Locate well on Section Plat on Reverse Side)

County: GRANT

Lease Name: EVANS Well #: 3-6R

Field Name: HUGOTON

Is this a Prorated/Spaced Field? Yes No

Target Formation(s): CHASE

Nearest Lease or unit boundary: 1250

Ground Surface Elevation: 2960 feet MSL

Water well within one-quarter mile: yes no

Public water supply within one mile: yes no

Depth to bottom of fresh water: 560

Depth to bottom of usable water: 580

Surface Pipe by Alternate: 1 2

Length of Surface Pipe Planned to be set: 600' MIN

Length of Conductor pipe required: NONE

Projected Total Depth: 3200' explor only/PBTD 2875'

Formation at Total Depth: CHASE

Water Source for Drilling Operations:

Well Farm Pond Other

DWR Permit #: _____

(Note: Apply for Permit with DWR)

Will Cores Be Taken? Yes No

If yes, proposed zone: _____

AFFIDAVIT

RECEIVED

The undersigned hereby affirms that the drilling, completion and eventual plugging of this well will comply with K.S.A. 55- 101 et, seq.
It is agreed that the following minimum requirements will be met:

FEB 07 2005

KCC WICHITA

1. Notify the appropriate district office **prior** to spudding of well;
2. A copy of the approved notice of intent to drill **shall be** posted on each drilling rig;
3. The minimum amount of surface pipe as specified below **shall be set** by circulating cement to the top; in all cases surface pipe **shall be set** through all unconsolidated materials plus a minimum of 20 feet into the underlying formation;
4. If the well is dry hole, an agreement between the operator and the district office on plug length and placement is **necessary prior to plugging**;
5. The appropriate district office will be notified before well is either plugged or production casing is cemented in;
6. If an ALTERNATE II COMPLETION, production pipe shall be cemented from below any usable water to surface within **120 days** of spud date. Or pursuant to Appendix "B" - Eastern Kansas surface casing order #133,891-C, which applies to the KCC District 3 area. alternate II cementing must be completed within 30 days of the spud date or the well shall be plugged. **In all cases, NOTIFY district office** prior to any cementing.

I hereby certify that the statements made herein are true and to the best of my knowledge and belief.

Date: February 2, 2005 Signature of Operator or Agent: Linda Kelly Title: ENGINEERING TECH

For KCC Use ONLY
API # 15- 067-21605-00-00
Conductor pipe required NONE feet
Minimum surface pipe required 600 feet per Alt. 1
Approved by: SP2.9.05
This authorization expires: 8.9.05
(This authorization void if drilling not started within 6 months of effective date.)
Spud date: _____ Agent _____

Remember to:

- File Drill Pit Application (form CDP-1) with Intent to Drill;
- File Completion Form ACO-1 within 120 days of spud date;
- File acreage attribution plat according to field proration orders;
- Notify appropriate district office 48 hours prior to workover or re-entry;
- Submit plugging report (CP-4) after plugging is completed;
- Obtain written approval before disposing or injecting salt water.
- If permit has expired (See: authorized expiration date) please check the box below and return to the address below

Well Not Drilled - Permit Expired

Signature of Operator or Agent: _____

Date: _____

IN ALL CASES PLOT THE INTENDED WELL ON THE PLAT BELOW

Plat of acreage attributable to a well in a prorated or spaced field

If the intended well is in a prorated or spaced field, please fully complete this side of the form. If the intended well is in a prorated or spaced field complete the plat below showing that the well will be properly located in relationship to other wells producing from the common source of supply. Please show all the wells within 1 mile of the boundaries of the proposed acreage attribution unit for gas wells and within 1/2 mile of the boundaries of the proposed acreage attribution unit for oil wells.

API No. 15- _____
 Operator PIONEER NATURAL RESOURCES
 Lease EVANS
 Well Number 3-6R
 Field HUGOTON


Location of Well: County: GRANT
 _____ 1250 feet from N / S Line of Section
 _____ 1250 feet from E / W Line of Section
 Sec 6 Twp 30 S. R. 35 East West

Number of Acres attributable to well: 640
 QTR/QTR/QTR of acreage: NE/4 - SW/4 - SW/4


Is Section X Regular or _____ Irregular
If Section is irregular, locate well from nearest corner boundary.
 Section corner used: _____ NE _____ NW _____ SE _____ SW

PLAT

*(Show location of the well and shade attributable acreage for prorated or spaced wells.)
 (Show footage to nearest lease or unit boundary line)*

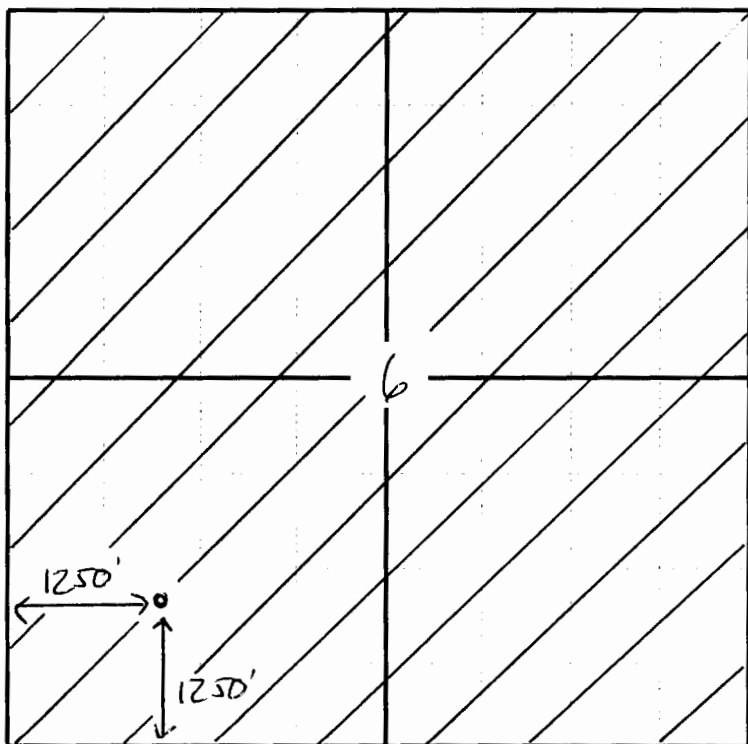

GRANT CO.

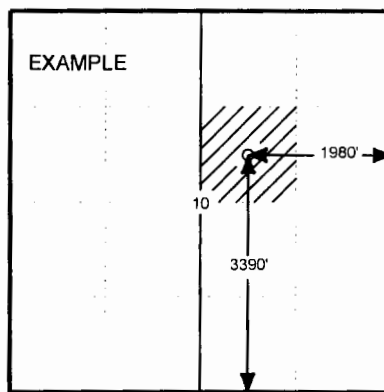

SEWARD CO.

In plotting the proposed location of the well, you must show;

1. The manner in which you are using the depicted plat by identifying section lines, i.e. 1 section, 1 section with 8 surrounding sections, 4 sections, etc.;
2. The distance of the proposed drilling location from the section's south/north and east/west; and 3.
3. The distance to the nearest lease or unit boundary line.
4. If proposed location is located within a prorated or spaced field a certificate of acreage attribution plat must be attached: (CO-7 for oil wells; CG-8 for gas wells).