


323
 15-039-2082-00-00

WELL PLUGGING RECORD

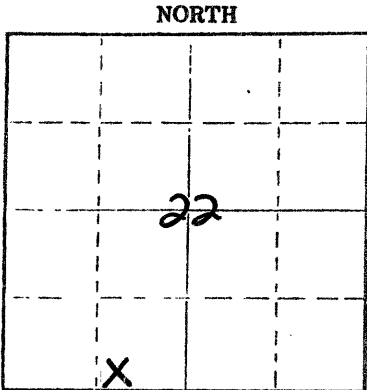

Locate well correctly on above Section Plat

Decatur County, Sec. 22 Twp. 5S Rge. 30 (W)
 Location as "NE/CNW/SW" or footage from lines SW SE SW
 Lease Owner Cities Service Oil Company
 Lease Name SCHMAHL Well No. #1
 Office Address P. O. Box 300 Tulsa, Okla. 74102
 Character of Well (completed as Oil, Gas or Dry Hole) Dry Hole
 Date well completed December 24, 1975
 Application for plugging filed (verbally) December 24, 1975
 Application for plugging approved (verbally) December 24, 1975
 Plugging commenced December 24, 1975
 Plugging completed December 24, 1975
 Reason for abandonment of well or producing formation No commercial quantity of oil or gas encountered.
 If a producing well is abandoned, date of last production 19
 Was permission obtained from the Conservation Division or its agents before plugging was commenced? Yes

Name of Conservation Agent who supervised plugging of this well Gilbert Balthazor
 Producing formation _____ Depth to top _____ Bottom _____ Total Depth of Well 4575
 Show depth and thickness of all water, oil and gas formations.

OIL, GAS OR WATER RECORDS

CASING RECORD

FORMATION	CONTENT	FROM	TO	SIZE	PUT IN	PULLED OUT
				8 5/8"	225'	none

Describe in detail the manner in which the well was plugged, indicating where the mud fluid was placed and the method or methods used in introducing it into the hole. If cement or other plugs were used, state the character of same and depth placed, from _____ feet to _____ feet for each plug set.

1st Plug was Set @ 1600' with 70 sx. cement
 2nd Plug was Set @ 200' with 20 sx. cement
 3rd Plug was Set @ 40' with 10 sx. cement
 Plug was down @ 4:30 p.m. December 24, 1975

RECEIVED
 STATE CORPORATION COMMISSION
 JAN 12 1976
 01-12-1976
 CONSERVATION DIVISION
 Wichita, Kansas

(If additional description is necessary, use BACK of this sheet)
 Name of Plugging Contractor Abercrombie Drilling, Inc.
 Address 801 Union Center, Wichita, Kansas 67202

STATE OF KANSAS COUNTY OF SEDGWICK ss.
 Jerry A. Langrehr-Exec. V.P. (employee of owner) or (owner or operator) of the above-described

well, being first duly sworn on oath, says: That I have knowledge of the facts, statements, and matters herein contained and the log of the above-described well as filed and that the same are true and correct. So help me God.

(Signature) Jerry A. Langrehr
 801 Union Center, Wichita, Ks. 67202
 (Address)

NOTARIES AND SWORN TO before me this 9th day of January, 1976
 PUBLIC My commission expires July 21, 1979

Sandra Richman
 Sandra Richman Notary Public.