


15-163-01300-00-a

WELL PLUGGING RECORD

Give All Information Completely
 Make Required Affidavit

COUNTY Roake SEC. 12 TWP. 6 S RGE. 18 W (W)
 Location as in quarters or footage from lines:
SE NE NW

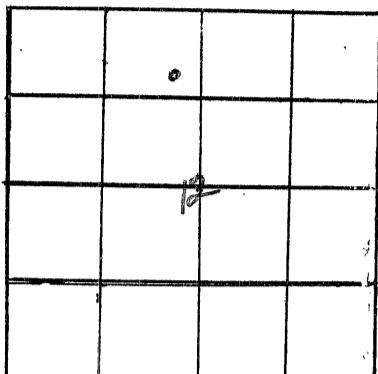

Locate Well
 correctly on above
 Section Platt.

Lease Owner Marilyn L. Chesney
 Lease Name Shubian Well No. 1
 Office Address 201 W 34, Nay, Kas.
 Character of Well (Completed as Oil, Gas or Dry Hole): Oil
 Date Well Completed 9/16/85
 Application for plugging filed _____
 Plugging commenced 7/22/85
 Plugging completed 7/22/85
 Reason for abandonment of well or producing formation _____

Saline water broken in
 Was permission obtained from the Conservation Division or it's
 Agent's before plugging was commenced? yes

Name of Conservation Agent who supervised plugging of this well Marion Schmidt
 Producing formation K.C. Lime Depth to top 3079 bottom 3292 T.D. 3300
 Show depth and thickness of all water, oil and gas formations.

OIL, GAS OR WATER RECORDS

Casing Record

Formation	Content	From	To	Size	Put in	Pulled Out
<u>K. C. Lime</u>	<u>oil</u>	<u>3079</u>	<u>3292</u>	<u>8"</u>	<u>269</u>	<u>none</u>

Describe in detail the manner in which the well was plugged, indicating where the mud fluid was placed and the method or methods used in introducing it into the hold. If cement or other plugs were used, state the character of same and depth placed, from _____ feet to _____ feet for each plug set. on loc - 1500 shs 60/40 Pa 670 gel 390cc
Run M/P the well @ 2318 - stop @ 2738. run tubing to 2694' start cmt
50 shs w/ 1 sh flange. Dept 7 1/2' sol water to balance. Pull thg to 2201.
Start cmt - 100 shs w/ 2 sh flange & 1 sh hallow. di 30'. to balance w/ 7 1/2
sh h water. Pull thg to 1206 - start cmt 100 shs 1 sh hallow, 1 sh flange
1 sh flange. Pull thg out of hole. Start cmt down annulus. Pump 450 shs
cmt 4-2 shs hallow. Jan 3' cmt - close MC 125". Run up in hole string 380.
Run tubing to 300' run 2 sh hallow - 50 shs cmt start. finish cmt. 1 sh flange
tubing out of hole fell down top 5 1/2' - dropping slowly. Hook the pump & pump 10 sh
down from 6' press the 250" - holding. Shut in Ann @ 290" - fell 5 1/2' from top out
of cmt - dropped to about 150' job complete

(If additional description is necessary, use BACK of this sheet)

Name of Plugging Contractor _____

STATE OF Kansas COUNTY OF Ellis, ss.
Marilyn L. Chesney (employee of owner) or (owner or operator) of the
 above-described well, being first duly sworn on oath, says: That I have knowledge of the
 facts, statements, and matters herein contained and the log of the above-described well as
 filed and that the same are true and correct. So help me God.



(Signature) Marilyn L. Chesney
201 W 34, Nay, Kas. 67601
 (Address)

SUBSCRIBED AND SWORN TO before me this 16 day of Aug, 19 85

Chris Schumacher
 Notary Public.

My Commission expires: 12-28-87

AUG 19 1985
 8-19-85
 CONSERVATION DIVISION
 Wichita, Kansas