


15-163-19006-00-00

Give All Information Completely
Make Required Affidavit
Mail or Deliver Report to:
Conservation Division
State Corporation Commission
211 No. Broadway
Wichita, Kansas

WELL PLUGGING RECORD

NORTH

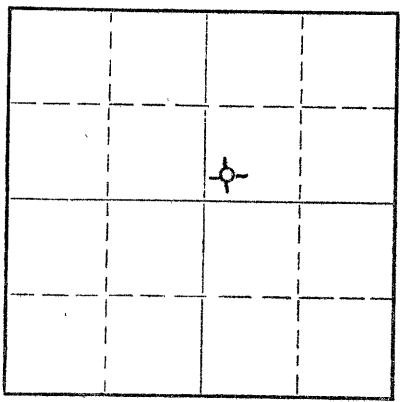

Locate well correctly on above Section Plat

Rooks County. Sec. 12 Twp 6S Rge. 18 (E) W (W)
Location as "NE/CNW/SW" or footage from lines SW SW NE
Lease Owner D. G. Hansen
Lease Name Hansen "G" Well No. 2
Office Address Logan, Kansas
Character of Well (completed as Oil, Gas or Dry Hole) Dry Hole
Date well completed November 14, 19 64
Application for plugging filed November 14, 19 64
Application for plugging approved November 14, 19 64
Plugging commenced November 14, 19 64
Plugging completed November 14, 19 64
Reason for abandonment of well or producing formation Too low structurally

If a producing well is abandoned, date of last production 19
Was permission obtained from the Conservation Division or its agents before plugging was commenced? Yes

Name of Conservation Agent who supervised plugging of this well Eldon Petty, Hays, Kansas
Producing formation Depth to top Bottom Total Depth of Well 3316 Feet
Show depth and thickness of all water, oil and gas formations.

OIL, GAS OR WATER RECORDS

CASING RECORD

FORMATION	CONTENT	FROM	TO	SIZE	PUT IN	PULLED OUT
				8-5/8"	201.82	none

Describe in detail the manner in which the well was plugged, indicating where the mud fluid was placed and the method or methods used in introducing it into the hole. If cement or other plugs were used, state the character of same and depth placed, from feet to feet for each plug set.

Filled hole with heavy mud to 540'. Set Plug.
Put in 20 sacks cement. Filled with heavy mud to 190'. Set plug. Put in 1/2 sack hulls and ~~and~~ 20 sacks cement. Filled with heavy mud to 40'. Set plug. Filled to top with 1/2 sack hulls and 10 sacks cement.

RECEIVED
STATE CORPORATION COMMISSION

NOV 24 1964

11-24-64
CONSERVATION DIVISION
Wichita, Kansas

(If additional description is necessary, use BACK of this sheet)
Name of Plugging Contractor C-G Drilling Co.
Address 107 Rule Building, Wichita, Kansas 67202

STATE OF KANSAS, COUNTY OF SEDGWICK, ss.
G. F. GALLOWAY (employee of owner) or (owner or operator) of the above-described

well, being first duly sworn on oath, says: That I have knowledge of the facts, statements, and matters herein contained and the log of the above-described well as filed and that the same are true and correct. So help me God.

(Signature) G. F. Galloway, 107 Rule Bldg. 67202
(Address)

SUBSCRIBED AND SWORN to before me this 17th day of November, 1964

My commission expires May 20, 1967
Vicky Jacobs Notary Public.

15-163-19066-0000

WELL LOG

OPERATOR: D. G. Hansen

WELL NAME: Hansen "G" #2 LOCATION: SW SW NE SEC. 12-6S-18W

COUNTY: Rooks STATE: Kansas

WELL COMMENCED: 11/7/64 WELL COMPLETED: 11/14/64

ELEVATION: 1911 K.B. TOTAL DEPTH: 3316'

PRODUCTION: D&A RIG NO: #1

CASING - 8-5/8": 201.82' (10 jts) OD Surface with 165 sx cement / 2% calcium chloride

5-1/2": _____

All Measurements taken from the top of rotary bushing.

FROM	TO	FORMATION	DEVIATION FROM VERTICAL	REMARKS:
0	875	Shale & Sand	500' - 1/4°	
875	1065	Sand	1000' - 1 1/2°	
1065	1290	Shale & Red Bed	1250' - 1°	
1290	1352	Shale		
1352	1396	Anhydrite		
1396	1885	Shale	1500' - 1°	
1885	3123	Shale & Lime	2000' - 1/4°	
3123	3316	Lime	2500' - 1/4°	DST 3160-3188'

RECEIVED
STATE CORPORATION COMMISSION

NOV 24 1964
11-24-64
CONSERVATION DIVISION
Wichita, Kansas

STATE OF KANSAS
COUNTY OF SEDGWICK) SS:

The undersigned hereby certifies that to the best of his knowledge and belief, the above facts are true and correct.

C-G DRILLING CO.

By *G. J. Newman*

SUBSCRIBED AND SWORN TO, BEFORE ME, This 17th day of NOVEMBER, 1964.

My comm. exp: May 20, 1967

Vicky Jacobs
Vicky Jacobs - Notary Public

