


15-163-19065-00-00

Give All Information Completely
Make Required Affidavit
Mail or Deliver Report to:
Conservation Division
State Corporation Commission
211 No. Broadway
Wichita, Kansas

WELL PLUGGING RECORD

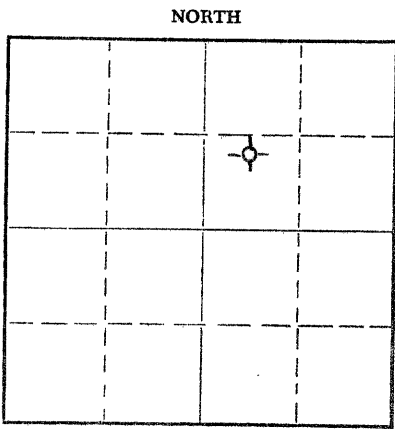

Locate well correctly on above Section Plat

Rooks County. Sec. 12 Twp. 6S Rge. 18 (X) (W)
Location as "NE/CNW/SW" or footage from lines C N/2 SW NE
Lease Owner D. G. Hansen
Lease Name Hansen "G" Well No. 1
Office Address Logan, Kansas
Character of Well (completed as Oil, Gas or Dry Hole) Dry Hole
Date well completed 11/7/ 19 64
Application for plugging filed 11/7/ 19 64
Application for plugging approved 11/7/ 19 64
Plugging commenced 11/7/ 19 64
Plugging completed 11/7/ 19 64
Reason for abandonment of well or producing formation Too low Structurally

If a producing well is abandoned, date of last production _____ 19 ____
Was permission obtained from the Conservation Division or its agents before plugging was commenced? Yes

Name of Conservation Agent who supervised plugging of this well Eldon Petty, Wagon, Kansas
Producing formation _____ Depth to top _____ Bottom _____ Total Depth of Well 3280 Feet
Show depth and thickness of all water, oil and gas formations.

OIL, GAS OR WATER RECORDS

CASING RECORD

FORMATION	CONTENT	FROM	TO	SIZE	PUT IN	PULLED OUT
				8-5/8"	237.53'	None

Describe in detail the manner in which the well was plugged, indicating where the mud fluid was placed and the method or methods used in introducing it into the hole. If cement or other plugs were used, state the character of same and depth placed, from _____ feet to _____ feet for each plug set.

Filled hole with heavy mud to 540'. Set Plug. Put in 20 sacks cement. Filled with heavy mud to 230'. Set Plug. Put in 20 sacks cement & 1/2 sack hulls. Filled with heavy mud to 40'. Set Plug. Filled to top with 1/2 sack hulls & 10 sacks cement.

RECEIVED
STATE CORPORATION COMMISSION
NOV 16 1964
CONSERVATION DIVISION
Wichita, Kansas
11-16-64

(If additional description is necessary, use BACK of this sheet)
Name of Plugging Contractor C-G Drilling Co.
Address 107 Rule Building, Wichita, Kansas

STATE OF KANSAS COUNTY OF SEDGWICK, ss.
G. F. Galloway (employee of owner) or (owner or operator) of the above-described well, being first duly sworn on oath, says: That I have knowledge of the facts, statements, and matters herein contained and the log of the above-described well as filed and that the same are true and correct. So help me God.
(Signature) G. F. Galloway
107 Rule Building
(Address)

SUBSCRIBED AND SWORN to before me this 9th day of November, 19 64

My commission expires May 20, 1967

Vicky Jacobs
Notary Public.

15-163-19065-00-00

WELL LOG

OPERATOR: D. G. Hansen

WELL NAME: Hansen "G" #1 LOCATION: C N/2 SW NE

COUNTY: Rooks STATE: Kansas

WELL COMMENCED: 10/29/64 WELL COMPLETED: 11/7/64

ELEVATION: 1886 K.B. TOTAL DEPTH: 3280'

PRODUCTION: D&A RIG NO: #1

CASING - 8-5/8": Set 237.53' (12 jts.)

5-1/2": _____

All Measurements taken from the top of rotary bushing.

FROM	TO	FORMATION	DEVIATION FROM VERTICAL	REMARKS:
0	280	Sand & Shale		
280	515	Shale	500' - 1/4°	
515	845	Sand & Shale		
845	1030	Sand	1000' - 1/4°	
1030	1335	Shale		
1335	1355	Anhydrite		
1355	1575	Anhydrite & Shale	1500' - 3/4°	
1575	1835	Shale & Shells		
1835	3010	Shale & Lime	2000' - 3/4°	DST 3087-3132'
3010	3280	Lime	2500' - 1/4°	DST 3131-3154'
				DST 3160-3174'
				DST 3187-3232'

RECEIVED
STATE CORPORATION COMMISSION

NOV 16 1964

11-16-64
CONSERVATION DIVISION
Wichita, Kansas

STATE OF KANSAS)
COUNTY OF SEDGWICK) SS:

The undersigned hereby certifies that to the best of his knowledge and belief, the above facts are true and correct.

C-G DRILLING CO.

By G. F. Galloway
G. F. Galloway

SUBSCRIBED AND SWORN TO, BEFORE ME, This 9th day of November, 1964

My comm. exp: May 20, 1967

Vicky Jacobs
Vicky Jacobs - Notary Public