


WELL PLUGGING RECORD

Give All Information Completely
Make Required Affidavit
Mail or Deliver Report to:
Conservation Division
State Corporation Commission
800 Bitting Building
Wichita, Kansas

NORTH

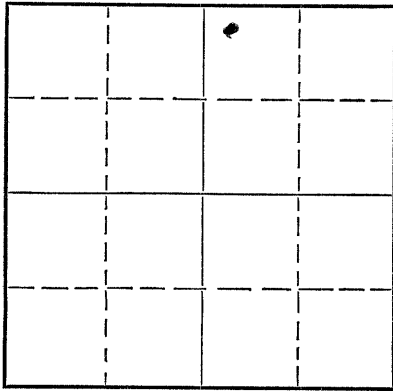

Locate well correctly on above
Section Plat

Rooks County. Sec. 12 Twp. 6 Rge. 18
Location as "NE/CNW $\frac{1}{4}$ SW $\frac{1}{4}$ " or footage from lines NW NW NE
Lease Owner Honaker Drlg Co
Lease Name Faubian Well No. 1
Office Address Box 435, Lawrence, Kansas
Character of Well (completed as Oil, Gas or Dry Hole) Dry Hole
Date well completed 2-28 1951
Application for plugging filed 3-7 1951
Application for plugging approved 3-7 1951
Plugging commenced March 12, 1951 19
Plugging completed March 14, 1951 19
Reason for abandonment of well or producing formation Dry

If a producing well is abandoned, date of last production 19____
Was permission obtained from the Conservation Division or its agents before plugging was commenced? Yes

Name of Conservation Agent who supervised plugging of this well Eldon Petty
Producing formation _____ Depth to top _____ Bottom _____ Total Depth of Well 3154 Feet
Show depth and thickness of all water, oil and gas formations.

OIL, GAS OR WATER RECORDS

CASING RECORD

Formation	Content	From	To	Size	Put In	Pulled Out
				5 1/2"	3154	2051'

Describe in detail the manner in which the well was plugged, indicating where the mud fluid was placed and the method or methods used in introducing it into the hole. If cement or other plugs were used, state the character of same and depth placed, from _____ feet to _____ feet for each plug set.

Rocked hole to 2800'. Run 4 sacks of cement.
Pumped in 75 sacks of cement, after pulling pipe

RECEIVED
STATE CORPORATION COMMISSION
MAR 30 1951
CONSERVATION DIVISION
Wichita, Kansas

3-30-51

(If additional description is necessary, use BACK of this sheet)
Correspondence regarding this well should be addressed to Honaker Drlg Co
Address Great Bend Lawrence, Kansas

STATE OF Kansas, COUNTY OF Barton, ss.
E. O. Squires (employee of owner) or (owner or operator) of the above-described well,
being first duly sworn on oath, says: That I have knowledge of the facts, statements, and matters herein contained and the log of the above-described well as filed and that the same are true and correct. So help me God.

(Signature) E. O. Squires
Great Bend, Kansas
(Address)

SUBSCRIBED AND SWORN to before me this 29th day of March, 1951

L. E. Caraway
Notary Public.

My commission expires 9-1-54

PLUGGING
FILE SEC 12 T 6 R 18 W
BOOK PAGE 65 LINE 34