

CARD MUST BE TYPED

State of Kansas
NOTICE OF INTENTION TO DRILL
(see rules on reverse side)

CARD MUST BE SIGNED

Starting Date:

4 2 85
month day year
11:25

API Number 15-

CAM
163-22,658-00-00

OPERATOR: License #

8925

NE. SW. SW
(location)

Sec 16. Twp 6. S, Rge 20.

East
 West

Name Liberty Operations and Completions, Inc.

Address 308 West Mill

City/State/Zip Plainville, KS 67663

Contact Person David L. Comeau

Phone (913) 434-4686

990
Ft North from Southeast Corner of Section

4290
Ft West from Southeast Corner of Section

(Note: Locate well on Section Plat on reverse side)

CONTRACTOR: License #

5665

Name Pioneer Drilling Company, Inc.

City/State Plainville, Kansas

Nearest lease or unit boundary line 990 feet.

County Rooks

Lease Name Geyer Well# 3

Domestic well within 330 feet: yes no

Municipal well within one mile: yes no

Well Drilled For:

Well Class:

Type Equipment:

- Oil Swd Infield
- Gas Inj Pool Ext.
- OWWO Expl Wildcat

- Mud Rotary
- Air Rotary
- Cable

If OWWO: old well info as follows:

Operator

Well Name

Comp Date Old Total Depth

Projected Total Depth 3720 feet

Projected Formation at TD Arbuckle

Expected Producing Formations Arbuckle

Depth to Bottom of fresh water 65 feet

Lowest usable water formation Dakota

Depth to Bottom of usable water 1100 feet

Surface pipe by Alternate: 1 2

Surface pipe to be set 240 feet

Conductor pipe if any required N/A feet

Ground surface elevation feet MSL

This Authorization Expires 10-2-85

Approved By 4-2-85

I certify that we will comply with K.S.A. 55-101, et seq., plus eventually plugging hole to K.C.C. specifications.

Date 4-1-85 Signature of Operator or Agent

Title Vice Pres.

MHC/WOHE 4-2-85

Must be filed with the K.C.C. five (5) days prior to commencing well
 This card void if drilling not started within six (6) months of date received by K.C.C.

CONSERVATION DIVISION
 WICHITA, KANSAS


APR 2 1985

4-2-85

STATE CORPORATION COMMISSION
 A Regular Section of Land
 1 Mile = 5,280 Ft.

Important procedures to follow:

1. Notify District office before setting surface casing.
2. Set surface casing by circulating cement to the top.
3. File completion forms ACO-1 with K.C.C. within 90 days of well completion, following instructions on ACO-1, side 1, and including copies of wireline logs.
4. Notify District office 48 hours prior to old well workover or re-entry.
5. Prior to plugging, prepare a plugging plan, then obtain agreement from the appropriate district office for an approved plugging plan.
6. Submit plugging report (CP-4) to K.C.C. after plugging is completed.
7. Obtain an approved injection docket number before disposing of salt water.
8. Notify K.C.C. within 10 days when injection commences or terminates.
9. If an alternate 2 completion, cement in the production pipe from below any usable water to surface within 120 days of spud date.

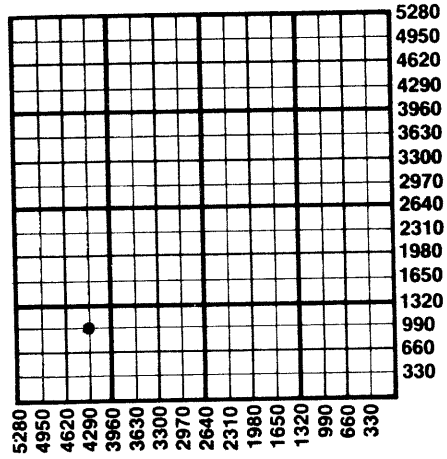

State Corporation Commission of Kansas
 Conservation Division
 200 Colorado Derby Building
 Wichita, Kansas 67202
 (316) 263-3238