

CARD MUST BE TYPED

State of Kansas
NOTICE OF INTENTION TO DRILL
(see rules on reverse side)

CARD MUST BE SIGNED

Starting Date: 4 4 85
month day year

API Number 15- 00163-22,659-00-00

OPERATOR: License # 8925

NW SW SW Sec 16 Twp 6 S, Rge 20
(location) East West

Name Liberty Operations and Completions, Inc.

Address 308 West Mill

990 Ft North from Southeast Corner of Section

City/State/Zip Plainville, KS 67663

4950 Ft West from Southeast Corner of Section

Contact Person David L. Comeau

(Note: Locate well on Section Plat on reverse side)

Phone (913) 434-4686

Nearest lease or unit boundary line 330 feet.

CONTRACTOR: License # 5665

County Rooks

Name Pioneer Drilling Company, Inc.

Lease Name Geyer Well# 4

City/State Plainville, Kansas

Domestic well within 330 feet: yes no

Well Drilled For: Well Class: Type Equipment:

Municipal well within one mile: yes no

Oil Swd Infield Mud Rotary

Gas Inj Pool Ext. Air Rotary

OWWO Expl Wildcat Cable

Depth to Bottom of fresh water 65 feet

Lowest usable water formation Dakota

If OWWO: old well info as follows:

Depth to Bottom of usable water 1100 feet

Operator

Surface pipe by Alternate: 1 2

Well Name

Surface pipe to be set 240 feet

Comp Date

Conductor pipe if any required N/A feet

Projected Total Depth 3720 feet

Ground surface elevation feet MSL

Projected Formation at TD Arbuckle

This Authorization Expires 10-2-85

Expected Producing Formations Arbuckle

Approved By 4-2-85

I certify that we will comply with K.S.A. 55-101, et seq., plus eventually plugging hole to K.C.C. specifications.

Date 4-1-85 Signature of Operator or Agent

Title Vice Pres.

2440140HE 4-2-85

Must be filed with the K.C.C. five (5) days prior to commencing well
 This card void if drilling not started within six (6) months of date received by K.C.C.

APR 2 1985

STATE CORPORATION COMMISSION


RECEIVED

A Regular Section of Land
1 Mile = 5,280 Ft.

4-2-85

Important procedures to follow :

1. Notify District office before setting surface casing.
2. Set surface casing by circulating cement to the top.
3. File completion forms ACO-1 with K.C.C. within 90 days of well completion, following instructions on ACO-1, side 1, and including copies of wireline logs.
4. Notify District office 48 hours prior to old well workover or re-entry.
5. Prior to plugging, prepare a plugging plan, then obtain agreement from the appropriate district office for an approved plugging plan.
6. Submit plugging report (CP-4) to K.C.C. after plugging is completed.
7. Obtain an approved injection docket number before disposing of salt water.
8. Notify K.C.C. within 10 days when injection commences or terminates.
9. If an alternate 2 completion, cement in the production pipe from below any usable water to surface within 120 days of spud date.

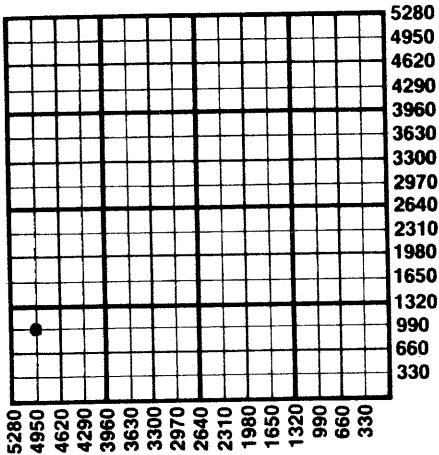

State Corporation Commission of Kansas
Conservation Division
200 Colorado Derby Building
Wichita, Kansas 67202
(316) 263-3238