

CARD MUST BE TYPED

State of Kansas
NOTICE OF INTENTION TO DRILL
(see rules on reverse side)

CARD MUST BE SIGNED

Starting Date: 12 - 24 - 85
month day year

API Number 15-

163-22,848-00-00

OPERATOR: License # ... 8925

. SW . SE . SE . Sec . 17 Twp . 6 . S, Rge . 20 .
(location) East West

Name Liberty Operations and Completions, Inc.

Address .. 308 West Mill

. 330 Ft North from Southeast Corner of Section

City/State/Zip .. Plainville, KS. 67663

. 990 Ft West from Southeast Corner of Section

Contact Person David L. Comeau

(Note: Locate well on Section Plat on reverse side)

Phone (913) 434-4686

Nearest lease or unit boundary line 330 feet.

CONTRACTOR: License # ... 5665

County Rocks

Name Pioneer Drilling Co., Inc.

Lease Name .. Freeman Well# .. 2

City/State .. Plainville, Kansas

Domestic well within 330 feet : yes no

Well Drilled For: Well Class: Type Equipment:

Municipal well within one mile : yes no

- Oil Swd Infield Mud Rotary
- Gas Inj Pool Ext. Air Rotary
- OWWO Expl Wildcat Cable

Depth to Bottom of fresh water 65 feet

Lowest usable water formation Dakota

If OWWO: old well info as follows:

Depth to Bottom of usable water 1175 feet

Operator

Surface pipe by Alternate : 1 2

Well Name

Surface pipe to be set 220 feet

Comp Date Old Total Depth

Conductor pipe if any required N/A feet

Projected Total Depth 3720 feet

Ground surface elevation feet MSL

Projected Formation at TD Arbuckle

This Authorization Expires 6-12-86

Expected Producing Formations Arbuckle

Approved By 12-12-85
RCA/HOATK

I certify that we will comply with K.S.A. 55-101, et seq., plus eventually plugging hole to K.C.C. specifications.


Date 12-12-85 Signature of Operator or Agent

Title Vice President

**Must be filed with the K.C.C. five (5) days prior to commencing well
This card void if drilling not started within six (6) months of date received by K.C.C.**

Important procedures to follow :

**A Regular Section of Land
1 Mile = 5,280 Ft.**

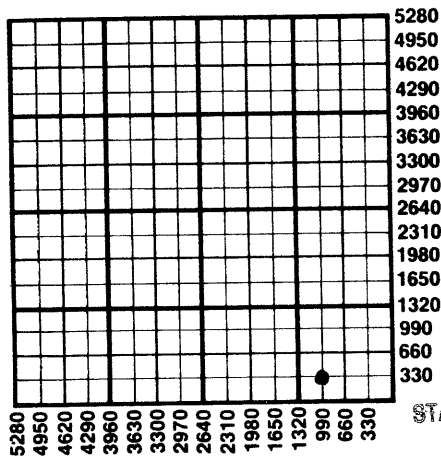

1. Notify District office before setting surface casing.
2. Set surface casing by circulating cement to the top.
3. File completion forms ACO-1 with K.C.C. within 90 days of well completion, following instructions on ACO-1, side 1, and including copies of wireline logs.
4. Notify District office 48 hours prior to old well workover or re-entry.
5. Prior to plugging, prepare a plugging plan, then obtain agreement from the appropriate district office for an approved plugging plan.
6. Submit plugging report (CP-4) to K.C.C. after plugging is completed.
7. Obtain an approved injection docket number before disposing of salt water.
8. Notify K.C.C. within 10 days when injection commences or terminates.
9. If an alternate 2 completion, cement in the production pipe from below any usable water to surface within 120 days of spud date.

RECEIVED
STATE CORPORATION COMMISSION

DEC 12 1985
12-12-85
CONSERVATION DIVISION
Wichita, Kansas

**State Corporation Commission of Kansas
Conservation Division
200 Colorado Derby Building
Wichita, Kansas 67202
(316)263-3238**